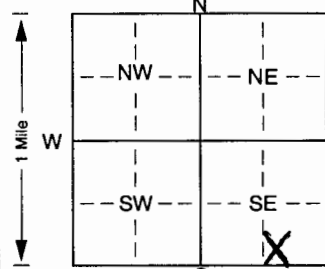


1 LOCATION OF WATER WELL:		Fraction $\frac{1}{4}$ SE $\frac{1}{4}$ Section Number 27	Township Number T 27 S	Range Number R 20 W
County: Sedgwick Distance and direction from nearest town or city street address of well if located within city?				
2 WATER WELL OWNER: Hal Daugherty 12500 E. Lynne				
RR#, St. Address, Box #: 630 Edgewater Rd. City, State, ZIP Code: Wichita, KS 67203				
Board of Agriculture, Division of Water Resources Application Number:				
3 LOCATE WELL'S LOCATION WITH AN "X" IN SECTION BOX:		4 DEPTH OF COMPLETED WELL: 50 ft. ELEVATION:		
		Depth(s) Groundwater Encountered: 23 ft. 2. ft. 3. ft. WELL'S STATIC WATER LEVEL: 23 ft. below land surface measured on mo/day/yr 10-11-02 Pump test data: Well water was ... ft. after ... hours pumping ... gpm Est. Yield 25 gpm: Well water was ... ft. after ... hours pumping ... gpm Bore Hole Diameter: 11 in. to 150 ft., and ... in. to ... ft. WELL WATER TO BE USED AS: 1 Domestic 3 Feedlot 6 Oil field water supply 9 Dewatering 12 Other (Specify below) 2 Irrigation 4 Industrial 7 Domestic (lawn & garden) 10 Monitoring well Was a chemical/bacteriological sample submitted to Department? Yes. No. X; If yes, mo/day/yr sample was submitted Water Well Disinfected? Yes X No		
5 TYPE OF BLANK CASING USED: 1 Steel 3 RMP (SR) 5 Wrought iron 8 Concrete tile CASING JOINTS: Glued. X Clamped. ... 2 PVC 4 ABS 6 Asbestos-Cement 9 Other (specify below) Welded ... Blank casing diameter 5 in. to 16 ft., Dia. 240 in. to ... ft., Dia. 110 psi Casing height above land surface: 12 in., weight 240 lbs./ft. Wall thickness or gauge No. 110 psi TYPE OF SCREEN OR PERFORATION MATERIAL: 1 Steel 3 Stainless steel 5 Fiberglass 7 PVC 10 Asbestos-cement 2 Brass 4 Galvanized steel 6 Concrete tile 8 RMP (SR) 11 Other (specify) ... 9 ABS 12 None used (open hole) SCREEN OR PERFORATION OPENINGS ARE: 1 Continuous slot 3 Mill slot 5 Gauzed wrapped 8 Saw cut 11 None (open hole) 2 Louvered shutter 4 Key punched 6 Wire wrapped 9 Drilled holes 7 Torch cut 10 Other (specify) ... ft. SCREEN-PERFORATED INTERVALS: From 16 ft. to 56 ft., From ... ft. to ... ft. GRAVEL PACK INTERVALS: From 22 ft. to 56 ft., From ... ft. to ... ft.				
6 GROUT MATERIAL: 1 Neat cement 2 Cement grout 3 Bentonite 4 Other ... Grout Intervals: From 3 ft. to 220 ft., From ... ft. to ... ft. What is the nearest source of possible contamination: 1 Septic tank 4 Lateral lines 7 Pit privy 10 Livestock pens 14 Abandoned water well 2 Sewer lines 5 Cess pool 8 Sewage lagoon 11 Fuel storage 15 Oil well/Gas well 3 Watertight sewer lines 6 Seepage pit 9 Feedyard 12 Fertilizer storage 16 Other (specify below) 13 Insecticide storage Direction from well? East How many feet? 60				
FROM TO LITHOLOGIC LOG		FROM TO PLUGGING INTERVALS		
0 2 topsoil				
2 10 clay				
10 20 med sand				
20 56 shale				
7 CONTRACTOR'S OR LANDOWNER'S CERTIFICATION: This water well was (1) constructed, (2) reconstructed, or (3) plugged under my jurisdiction and was completed on (mo/day/year) 10-11-02 and this record is true to the best of my knowledge and belief. Kansas Water Well Contractor's Licence No. 318 This Water Well Record was completed on (mo/day/yr) 10-16-02 under the business name of Weninger Drilling Inc. by (signature) [Signature]				
INSTRUCTIONS: Use typewriter or ball point pen. PLEASE PRESS FIRMLY and PRINT clearly. Please fill in blanks, underline or circle the correct answers. Send top three copies to Kansas Department of Health and Environment, Bureau of Water, Topeka, Kansas 66620-0001. Telephone 785-296-5524. Send one to WATER WELL OWNER and retain one for your records. Fee of \$5.00 for each constructed well.				