

1	LOCATION OF WATER WELL:	Fraction	Section Number	Township Number	Range Number
County:	<i>Sedgwick</i>	<i>NN 1/4 NE 1/4 NW 1/4</i>	<i>25</i>	T <i>27</i> S	R <i>2E</i> E/W

Distance and direction from nearest town or city street address of well if located within city?

845 S. Cactus, Wichita


2 WATER WELL OWNER: Green Williams

RR#, St. Address, Box # : 845 S. Cactus
City, State, ZIP Code : Wichita KS 67230

Board of Agriculture, Division of Water Resources
Application Number:

3	LOCATE WELL'S LOCATION WITH	4	DEPTH OF COMPLETED WELL 90
---	-----------------------------	---	----------------------------------

AN "X" IN SECTION BOX:

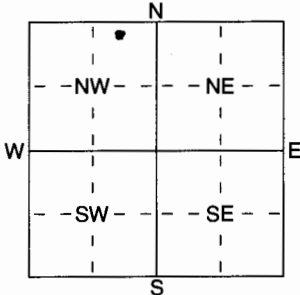

Depth(s) Groundwater Encountered 1 ft. 2 ft. 3 ft.

WELL'S STATIC WATER LEVEL 32 ft. below land surface measured on mo/day/yr 4-1-02

Pump test data: Well water was ft. after hours pumping gpm

Est. Yield gpm: Well water was ft. after hours pumping gpm

WELL WATER TO BE USED AS: 5 Public water supply 8 Air conditioning 11 Injection well

1 Domestic 3 Feedlot 6 Oil field water supply 9 Dewatering 12 Other (Specify below)

2 Irrigation 4 Industrial ☒ Domestic (lawn & garden) 10 Monitoring well

Was a chemical/bacteriological sample submitted to Department? Yes No X ; If yes, mo/day/yr sample was submitted
Water Well Disinfected? Yes X No

5	TYPE OF BLANK CASING USED:
---	----------------------------

1 Steel
2 PVC
3 RMP (SR)
4 ABS

5 Wrought iron
6 Asbestos-Cement
7 Fiberglass

8 Concrete tile
9 Other (specify below)

CASING JOINTS: Glued Clamped
Welded
Threaded

Blank casing diameter 5 in. to 70 ft., Dia in. to ft., Dia in. to ft.

Casing height above land surface 12 in., weight lbs./ft. Wall thickness or gauge No. SDR 24

TYPE OF SCREEN OR PERFORATION MATERIAL:

1 Steel
2 Brass
3 Stainless Steel
4 Galvanized Steel

5 Fiberglass
6 Concrete tile

7 PVC

8 RMP (SR)
9 ABS

10 Asbestos-Cement

11 Other (Specify)
12 None used (open hole)

SCREEN OR PERFORATION OPENINGS ARE:

1 Continuous slot
2 Louvered shutter
3 Mill slot
4 Key punched

5 Guazed wrapped
6 Wire wrapped
7 Torch cut

8 Saw cut
9 Drilled holes
10 Other (specify)
11 None (open hole)

SCREEN-PERFORATED INTERVALS: From 70 ft. to 70 ft., From _____ ft. to _____ ft.

From ft. to ft., From ft. to ft.

GRAVEL PACK INTERVALS: From ft. to ft., From ft. to ft.

6	GROUT MATERIAL:	1 Neat cement	2 Cement grout	3 Bentonite	4 Other
---	-----------------	---------------	----------------	-------------	---------------

Grout Intervals: From 4 ft. to 20 ft., From _____ ft. to _____ ft., From _____ ft. to _____ ft.

What is the nearest source of possible contamination:

1 Septic tank	4 Lateral lines	7 Pit privy	11 Fuel storage	15 Oil well/Gas well
2 Sewer lines	5 Cess pool	8 Sewage lagoon	12 Fertilizer storage	16 Other (specify below)
3 Watertight sewer lines	6 Seepage pit	9 Feedyard	13 Insecticide storage	

Direction from well?

How many feet?

[illegible]

7 CONTRACTOR'S OR LANDOWNER'S CERTIFICATION: This water well was (1) constructed, (2) reconstructed, or (3) plugged under my jurisdiction and was completed on (mo/day/year) 2-1-82 and this record is true to the best of my knowledge and belief. Kansas

Water Well Contractor's Licence No. 171 This Water Well Record was completed on (mo/day/yr) 7/24-02
under the business name of G & S Drilling, Inc by (signature) [Signature]