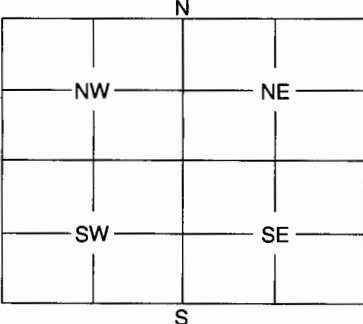


1	LOCATION OF WATER WELL:	Fraction SW SE SE NE 1/4 1/4 1/4	Section 15	Number	Township 27s	Number	Range 2 E	Number E/W																											
County: <u>SEDGWICK</u>																																			
Distance and direction from nearest town or city street address of well if located within city? <u>930 PRESERVE COURT</u>																																			
2	WATER WELL OWNER: <u>DAVID MURRY</u> RR #, St. Address, Box #: <u>930 PRESERVE COURT</u> City, State, ZIP Code: <u>WICHITA, KS 67206</u>																																		
Board of Agriculture, Division of Water Resources Application Number: _____																																			
3	MARK WELL'S LOCATION WITH AN "X" IN SECTION BOX:		4 DEPTH OF WELL <u>104</u> ft. WELL'S STATIC WATER LEVEL <u>62</u> ft. WELL WAS USED AS: <table style="width:100%;"> <tr> <td>1 Domestic</td> <td>5 Public Water Supply</td> <td>9 Dewatering</td> </tr> <tr> <td>2 Irrigation</td> <td>6 Oil Field Water Supply</td> <td>10 Monitoring Well</td> </tr> <tr> <td>3 Feedlot</td> <td>7 Domestic (Lawn & Garden)</td> <td>11 Injection Well</td> </tr> <tr> <td>4 Industrial</td> <td>8 Air Conditioning</td> <td>12 Other</td> </tr> </table> Was a chemical / bacteriological sample submitted to Department? Yes No <u>X</u> If yes, mo/day/yr sample was submitted Water Well Disinfected: Yes <u>X</u> No						1 Domestic	5 Public Water Supply	9 Dewatering	2 Irrigation	6 Oil Field Water Supply	10 Monitoring Well	3 Feedlot	7 Domestic (Lawn & Garden)	11 Injection Well	4 Industrial	8 Air Conditioning	12 Other															
1 Domestic	5 Public Water Supply	9 Dewatering																																	
2 Irrigation	6 Oil Field Water Supply	10 Monitoring Well																																	
3 Feedlot	7 Domestic (Lawn & Garden)	11 Injection Well																																	
4 Industrial	8 Air Conditioning	12 Other																																	
																																			
5	TYPE OF BLANK CASING USED:																																		
<table style="width:100%;"> <tr> <td>1 Steel</td> <td>3 RMP (SR)</td> <td>5 Wrought</td> <td>7 Fiberglass</td> <td>9 Other (Specify below)</td> </tr> <tr> <td>2 PVC</td> <td>4 ABS</td> <td>6 Asbestos-Cement</td> <td>8 Concrete Tile</td> <td></td> </tr> </table> Blank casing diameter <u>5</u> in. Was casing pulled? Yes No <u>X</u> If yes, how much Casing height above or below land surface <u>24"</u> in.									1 Steel	3 RMP (SR)	5 Wrought	7 Fiberglass	9 Other (Specify below)	2 PVC	4 ABS	6 Asbestos-Cement	8 Concrete Tile																		
1 Steel	3 RMP (SR)	5 Wrought	7 Fiberglass	9 Other (Specify below)																															
2 PVC	4 ABS	6 Asbestos-Cement	8 Concrete Tile																																
6	GROUT PLUG MATERIAL: 1 Neat cement 2 Cement grout 3 <u>Bentonite</u> 4 Other Grout Plug Intervals: From ft. to ft., From ft. to ft., From ft. to ft. What is the nearest source of possible contamination: <table style="width:100%;"> <tr> <td>1 Septic tank</td> <td>6 Seepage pit</td> <td>11 Fuel storage</td> <td>16 Other (specify below)</td> </tr> <tr> <td>2 Sewer lines</td> <td>7 Pit privy</td> <td>12 Fertilizer storage</td> <td rowspan="4"><u>1 YARD IRRIGATION WELL</u></td> </tr> <tr> <td>3 Watertight sewer lines</td> <td>8 Sewage lagoon</td> <td>13 Insecticide storage</td> </tr> <tr> <td>4 Lateral lines</td> <td>9 Feedyard</td> <td>14 Abandoned water well</td> </tr> <tr> <td>5 Cess pool</td> <td>10 Livestock pens</td> <td>15 Oil well/Gas well</td> </tr> </table> Direction from well? <u>EAST</u> How many feet? <u>150'</u>								1 Septic tank	6 Seepage pit	11 Fuel storage	16 Other (specify below)	2 Sewer lines	7 Pit privy	12 Fertilizer storage	<u>1 YARD IRRIGATION WELL</u>	3 Watertight sewer lines	8 Sewage lagoon	13 Insecticide storage	4 Lateral lines	9 Feedyard	14 Abandoned water well	5 Cess pool	10 Livestock pens	15 Oil well/Gas well										
1 Septic tank	6 Seepage pit	11 Fuel storage	16 Other (specify below)																																
2 Sewer lines	7 Pit privy	12 Fertilizer storage	<u>1 YARD IRRIGATION WELL</u>																																
3 Watertight sewer lines	8 Sewage lagoon	13 Insecticide storage																																	
4 Lateral lines	9 Feedyard	14 Abandoned water well																																	
5 Cess pool	10 Livestock pens	15 Oil well/Gas well																																	
<table border="1" style="width:100%; border-collapse: collapse;"> <thead> <tr> <th style="width:15%;">FROM</th> <th style="width:15%;">TO</th> <th style="width:70%;">PLUGGING MATERIALS</th> </tr> </thead> <tbody> <tr> <td>104'</td> <td>39'</td> <td>SAND</td> </tr> <tr> <td>39'</td> <td>2'</td> <td>BENTONITE</td> </tr> <tr> <td>2'</td> <td>0'</td> <td>CLAY SOIL</td> </tr> <tr><td> </td><td> </td><td> </td></tr> <tr><td> </td><td> </td><td> </td></tr> <tr><td> </td><td> </td><td> </td></tr> <tr><td> </td><td> </td><td> </td></tr> <tr><td> </td><td> </td><td> </td></tr> </tbody> </table>									FROM	TO	PLUGGING MATERIALS	104'	39'	SAND	39'	2'	BENTONITE	2'	0'	CLAY SOIL															
FROM	TO	PLUGGING MATERIALS																																	
104'	39'	SAND																																	
39'	2'	BENTONITE																																	
2'	0'	CLAY SOIL																																	
7	CONTRACTOR'S OF LANDOWNER'S CERTIFICATION: This water well was plugged under my jurisdiction and was completed on (mo/day/year) <u>11-26-03</u> and this record is true to the best of my knowledge and belief. Kansas Water Well Contractor's License No. <u>699</u> This Water Well Record was completed on (mo/day/year) under the business name of <u>FLINT HILLS WINDMILL AND PUMP SERVICE</u> by (signature) <u>[Signature]</u> <u>BENTON, KS 67017</u>																																		
INSTRUCTIONS: Use typewriter or ball point pen. Please press firmly and print clearly. Please fill in blanks, underline or circle the correct answers. Send top three copies to Kansas Department of Health and Environment, Bureau of Water, Geology Section, 1000 SW Jackson St., Ste. 420, Topeka, Kansas 66612-1367. Telephone: 785/296-5522. Send one to Water Well Owner and retain one for your records.																																			