

1	LOCATION OF WATER WELL	Fracture	Section Number	Township Number	Range Number
County:	Sedgwick	NE 1/4 NE 1/4 NW 1/4	35	T 27 S	R 20 E

Distance and direction from nearest town or city street address of well if located within city?


2	WATER WELL OWNER:
---	-------------------

RR#, St. Address, Box # :
City, State, ZIP Code :

Board of Agriculture, Division of Water Resources
Application Number:

3 LOCATE WELL'S LOCATION WITH

AN "X" IN SECTION BOX:

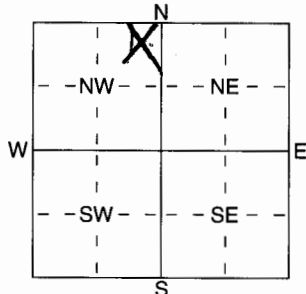

DEPTH OF COMPLETED WELL

Depth(s) Groundwater Encountered 1 ft. 2 ft. 3 ft.
WELL'S STATIC WATER LEVEL 26 ft. below land surface measured on mo/day/yr 8-26-04
Pump test data: Well water was ft. after hours pumping gpm
Est. Yield 25 gpm: Well water was ft. after hours pumping gpm
WELL WATER TO BE USED AS: 5 Public water supply 8 Air conditioning 11 Injection well
1 Domestic 3 Feedlot 6 Oil field water supply 9 Dewatering 12 Other (Specify below)
2 Irrigation 4 Industrial 7 Domestic (lawn & garden) 10 Monitoring well

Was a chemical/bacteriological sample submitted to Department? Yes No X; If yes, mo/day/hrs sample was submitted
Water Well Disinfected? Yes ✓ No

5	TYPE OF BLANK CASING USED:
---	----------------------------

- 1 Steel
2 PVC
3 RMP (SR)
4 ABS

- 5 Wrought iron
6 Asbestos-Cement
7 Fiberglass

- 8 Concrete tile
9 Other (specify below)

CASING JOINTS: Glued ☒ Clamped
Welded
Threaded

Blank casing diameter in. to ft. Dia in. to ft. Dia in. to ft.

Casing height above land surface 12 in., weight 240 lbs./ft. Wall thickness or gauge No. 160B31

TYPE OF SCREEN OR PERFORATION MATERIAL:

- 1 Steel
2 Brass
3 Stainless Steel
4 Galvanized Steel

- 5 Fiberglass
6 Concrete tile

- 7 PVC
8 RMP (SR)
9 ABS

- 10 Asbestos-Cement
11 Other (Specify)
12 None used (open hole)

SCREEN OR PERFORATION OPENINGS ARE:

- 1 Continuous slot
2 Louvered shutter
3 Mill slot
4 Key punched

- 5 Guazed wrapped
6 Wire wrapped
7 Torch cut

- 8 Saw cut
9 Drilled holes
10 Other (specify) ft.
11 None (open hole)

SCREEN-PERFORATED INTERVALS:

From 39 ft. to 64 ft., From ft. to ft.
From ft. to ft. From ft. to ft.

GRAVEL PACK INTERVALS:

From 26 ft. to 64 ft. From ft. to ft. From ft. to ft.
From ft. to ft. From ft. to ft.

5	GROUT MATERIAL:
---	-----------------

- 1 Neat cement 76 2 Cement grout

- ### 3 Bentonite

- 4 Other.

Grout Intervals: From 3 ft. to 46 ft., From _____ ft. to _____ ft., From _____ ft. to _____ ft.

What is the nearest source of possible contamination:

- | | |
|--------------------------|-----------------|
| 1 Septic tank | 4 Lateral lines |
| 2 Sewer lines | 5 Cess pool |
| 3 Watertight sewer lines | 6 Seepage pit |

- 7 Pit privy
8 Sewage lagoon
9 Feedyard

- | | |
|------------------------|--------------------------|
| 10 Livestock pens | 14 Abandoned water well |
| 11 Fuel storage | 15 Oil well/Gas well |
| 12 Fertilizer storage | 16 Other (specify below) |
| 13 Insecticide storage | |

Direction from well?

lines 6 Seepage
north

How many feet?

20

[illegible]

CONTRACTOR'S OR LANDOWNER'S CERTIFICATION: This water well was (1) constructed, (2) reconstructed, or (3) plugged under my jurisdiction and was completed on (mo/day/year) 8-26-04 and this record is true to the best of my knowledge and belief. Kansas Water Well Contractor's Licence No. 318 This Water Well Record was completed on (mo/day/yr) 8-27-04 under the business name of Penimer Drilling Inc. by (signature) [Signature]