WATER WELL RECORD Form WWC-5 KSA 82a-1212 ID No. _____

1 LOCATION OF WATER WELL:	Fraction	Section Number	Township Number	Range Number
County: SEDGWICK	SW ¼ SW ¼ NW ¼ SE ¼	27	T 27S S	R 2E E/W

Distance and direction from nearest town or city street address of well if located within city?
1025 S. BRACKEN; WICHITA

2 WATER WELL OWNER: STACEY THOMASON
RR#, St. Address, Box # : 1025 S. BRACKEN
City, State, ZIP Code : WICHITA, KS
Board of Agriculture, Division of Water Resources
Application Number:

3 LOCATE WELL'S LOCATON WITH AN "X" IN SECTION BOX:

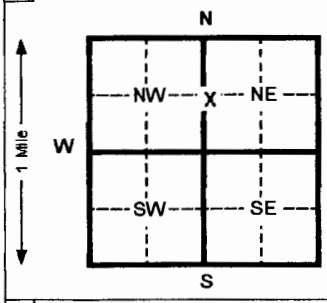

4 DEPTH OF COMPLETED WELL 87 ft. ELEVATION:
Depth(s) Groundwater Encountered 1 29 ft. 2 ft. 3 ft.
WELL'S STATIC WATER LEVEL 29 ft. below land surface measured on mo/day/yr 9/9/04
Pump test data: Well water was ft. after hours pumping gpm
Est. Yield gpm: Well water was ft. after hours pumping gpm
Bore Hole Diameter 10 in. to 87 ft. and in. to ft.
WELL WATER TO BE USED AS: 1 Domestic 3 Feed lot 5 Public water supply 6 Oil field water supply 8 Air conditioning 9 Dewatering 11 Injection well 12 Other (Specify below)
2 Irrigation 4 Industrial 7 Lawn and garden (domestic) 10 Monitoring well
Was a chemical/bacteriological sample submitted to Department? Yes No X If yes, mo/day/yr sample was submitted
Water Well Disinfected? Yes X No

5 TYPE OF BLANK CASING USED: 1 Steel 2 PVC 3 RMP (SR) 4 ABS 5 Wrought Iron 6 Asbestos-Cement 7 Fiberglass 8 Concrete tile 9 Other (specify below)
CASING JOINTS: Glued X Clamped Welded Threaded
Blank casing diameter 5 in. to 87 ft., Dia in. to ft., Dia in. to ft.
Casing height above land surface 16 in., weight 160 lbs./ft. Wall thickness or gauge No. 26
TYPE OF SCREEN OR PERFORATION MATERIAL: 1 Steel 2 Brass 3 Stainless steel 4 Galvanized steel 5 Fiberglass 6 Concrete tile 7 PVC 8 RMP (SR) 9 ABS 10 Asbestos-cement 11 Other (specify) 12 None used (open hole)
SCREEN OR PERFORATION OPENINGS ARE: 1 Continuous slot 2 Louvered shutter 3 Mill slot 4 Key-punched 5 Gauzed wrapped 6 Wire wrapped 7 Torch cut 8 Saw cut 9 Drilled holes 10 Other (specify) 11 None (open hole)
SCREEN-PERFORATED INTERVALS: From 47 ft. to 87 ft. From ft. to ft.
From ft. to ft. From ft. to ft.
GRAVEL PACK INTERVALS: From 24 ft. to 87 ft. From ft. to ft.
From ft. to ft. From ft. to ft.

6 GROUT MATERIAL: 1 Neat cement 2 Cement grout 3 Bentonite 4 Other
Grout Intervals From 4 ft. to 24 ft. From ft. to ft. From ft. to ft.
What is the nearest source of possible contamination: 1 Septic tank 2 Sewer lines 3 Watertight sewer lines 4 Lateral lines 5 Cess pool 6 Seepage pit 7 Pit privy 8 Sewage lagoon 9 Feedyard 10 Livestock pens 11 Fuel storage 12 Fertilizer storage 13 Insecticide storage 14 Abandoned water well 15 Oil well/ Gas well 16 Other (specify below)
Direction from well? WEST How many feet? 19

FROM	TO	CODE	LITHOLOGIC LOG	FROM	TO	PLUGGING INTERVALS
0	3		TOPSOIL			
3	14		TAN CLAY			
14	31		TAN SHALE			
31	47		BLUE SHALE			
47	51		RED SHALE			
51	82		BLUE SHALE/LIMESTONE			
82	87		WHITE LIMESTONE			

RECEIVED
OCT 11 2004
BUREAU OF WATER

7 CONTRACTOR'S OR LANDOWNER'S CERTIFICATION: This water well was (1) constructed, (2) reconstructed, or (3) plugged under my jurisdiction and was completed on (mo/day/yr) 9/9/04 and this record is true to the best of my knowledge and belief. Kansas Water Well Contractor's License No. 611 This Water Well Record was completed on (mo/day/yr) 10/3/04
under the business name of CHASE DRILLING by (signature) R Chase

INSTRUCTIONS:. Please fill in blanks and circle the correct answers. Send three copies to Kansas Department of Health and Environment, Bureau of Water, 1000 S W Jackson St., Ste. 420, Topeka, Kansas 66612-1367. Telephone: 913-296-5545. Send one to WATER WELL OWNER and retain one for your records.

OFFICE USE ONLY T R SEC