

1 LOCATION OF WATER WELL:

County: Sedgwick

Fraction

SE 1/4 SE 1/4 SE 1/4

Section Number

18

Township Number

T 27 S

Range Number

R 2 E


Distance and direction from nearest town or city street address of well if located within city?

7990 E. Central Ave → Located to the west of 7990 in parking lotMW-12

2 WATER WELL OWNER:

RR#, St. Address, Box # : Presto 7990 E. CentralCity, State, ZIP Code : Wichita, KS 67201Board of Agriculture, Division of Water Resources
Application Number:

3 LOCATE WELL'S LOCATION WITH AN "X" IN SECTION BOX:

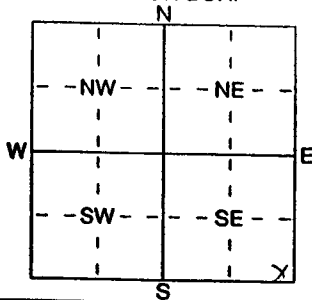

4 DEPTH OF COMPLETED WELL

15.5'ELEVATION: Not surveyed yet

Depth(s) Groundwater Encountered 1 ft. 2 ft. 3 ft.

WELL'S STATIC WATER LEVEL ft. below land surface measured on mo/day/yr

Pump test data: Well water was ft. after hours pumping

Est. Yield gpm: Well water was ft. after hours pumping

WELL WATER TO BE USED AS: 5 Public water supply 8 Air conditioning 11 Injection well

1 Domestic 3 Feedlot 6 Oil field water supply 9 Dewatering 12 Other (Specify below)

2 Irrigation 4 Industrial 7 Domestic (lawn & garden) 10 Monitoring well

Was a chemical/bacteriological sample submitted to Department? Yes No; If yes, mo/day/yr sample was submittedWater Well Disinfected? Yes No

5 TYPE OF BLANK CASING USED:

1 Steel

3 RMP (SR)

5 Wrought iron

8 Concrete tile

CASING JOINTS: Glued Clamped

2 PVC

4 ABS

6 Asbestos-Cement

9 Other (specify below)

Welded

Blank casing diameter

2in. to 5.5

ft., Dia

in. to ft., Dia

Casing height above land surface

0

in., weight

lbs./ft. Wall thickness or gauge No. 5.6 4.0

TYPE OF SCREEN OR PERFORATION MATERIAL:

1 Steel

3 Stainless Steel

5 Fiberglass

7 PVC

8 RMP (SR)

10 Asbestos-Cement

2 Brass

4 Galvanized Steel

6 Concrete tile

9 ABS

11 Other (Specify)

12 None used (open hole)

SCREEN OR PERFORATION OPENINGS ARE:

1 Continuous slot

3 Mill slot

5 Gauzed wrapped

8 Saw cut

11 None (open hole)

2 Louvered shutter

4 Key punched

6 Wire wrapped

9 Drilled holes

7 Torch cut

10 Other (specify)

SCREEN-PERFORATED INTERVALS:

From 5.5ft. to 15.5

ft., From ft. to

From ft. to

ft., From ft. to

GRAVEL PACK INTERVALS:

From 4.5ft. to 15.5

ft., From ft. to

From ft. to

ft., From ft. to

6 GROUT MATERIAL:

1 Neat cement

2 Cement grout

3 Bentonite

4 Other

Grout intervals: From (2) 0 ft. to 2 ft., From (3) 2 ft. to 4.5 ft., From ft. to

What is the nearest source of possible contamination:

1 Septic tank

4 Lateral lines

7 Pit privy

10 Livestock pens

14 Abandoned water well

2 Sewer lines

5 Cess pool

8 Sewage lagoon

11 Fuel storage

15 Oil well/Gas well

3 Watertight sewer lines

6 Seepage pit

9 Feedyard

12 Fertilizer storage

16 Other (specify below)

13 Insecticide storage

Direction from well? EastHow many feet? Approx. 250'

FROM	TO	LITHOLOGIC LOG	FROM	TO	PLUGGING INTERVALS
0	6"	Asphalt			
6"	3'	Clay, brown, slightly moist no odor			
3'	5'	Silty clay, light brown, sl. plastic, no odor			
10'	12	Silty clay, light grayish brown some chalk fragments, slightly plastic, no odor			
		TD = 15.5			

RECEIVED

NOV 17 2004

BUREAU OF WATER

7 CONTRACTOR'S OR LANDOWNER'S CERTIFICATION: This water well was (1) constructed, (2) reconstructed, or (3) plugged under my jurisdiction and was

completed on (mo/day/year) 11/2/04 and this record is true to the best of my knowledge and belief. KansasWater Well Contractor's Licence No 705This Water Well Record was completed on (mo/day/yr) 11-16-04under the business name of HANDIEKby (signature) [Signature]