


1	LOCATION OF WATER WELL: Sedgwick	FRACTION SW 1/4 NE 1/4 SW 1/4	SECTION NUMBER 35	TOWNSHIP NUMBER T 27 S	RANGE NUMBER R 2E E/W
---	--	---	-----------------------------	----------------------------------	---------------------------------

Distance and direction from nearest town or city street address of well if located within city?

2018 Triplecrown Wichita, Kansas

2	WATER WELL OWNER:	OTTEN HOMES INC.		Board of Agriculture, Division of Water Resource
	RR#,ST. ADDRESS,BOX #:	P.O. Box 159		
	CITY, STATE:	Rosehill, Kansas	ZIP CODE:	Application Number:

3	LOCATE WELL'S LOCATION	4	DEPTH OF COMPLETED WELL: 110 ft.	ELEVATION:
---	------------------------	---	---	------------

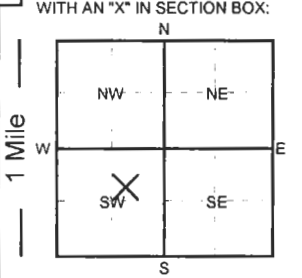

4 DEPTH OF COMPLETED WELL:		110		ft.		ELEVATION:			
Depth of groundwater Encountered:				ft.				ft.	
WELL'S STATIC WATER LEVEL		40		FT. BELOW LAND SURFACE MEASURED ON		mo/day/yr:		12/21/04	
Pump test data:		Well water was		ft. after		hours of pumping @		gpm	
Est. Yield:		gpm		Well water was		ft. after		hours of pumping @	
Bore Hole Diameter		12		in.		to 110		ft. and	
WELL WATER TO BE USED AS:									
1. Domestic		3. Feedlot		5. Public water supply		7. Lawn and garden only		9. Dewatering	
								11. Injection well	
2. Irrigation		4. Industrial		6. Oil field water supply		8. Air conditioning		10. Monitoring well	
Was a chemical/bacteriological sample submitted to Department?		YES		NO				; If yes, what mo/day/yr was sample submitted	
		YES		NO				YES NO	

5		TYPE OF CASING USED:		5. Wrought Iron		7. Fiberglass		9. Other (Specify below)		CASING JOINTS: <u>Glued</u>		Threaded	
1. Steel		3. RPM (SR)								Welded		Clamped	
<u>2. PVC</u>		4. ABS		6. Asbestos-Cement		8. Concrete tile		SDR-26					
Blank casing diameter		5 in.		to 50 ft.,		Dia.		in.		to ft.,		Dia. in. to ft.	
Casing height above land surface:		12 in.,		Weight:		2.35 lbs. / ft.		Wall thickness or gauge No.		.214			
TYPE OF SCREEN OR PERFORATION MATERIAL:													
1. Steel		3. Stainless Steel		5. Fiberglass		<u>7. PVC</u>		9. ABS		11. Other (specify)			
2. Brass		4. Galvanized		6. Concrete Tile		8. RMP (SR)		10. Asbestos-Cement		12. None used (open hole)			
SCREEN OR PERFORATION OPENINGS ARE:													
1. Continuous slot		3. Mill slot		5. Gauzed wrapped		7. Torch cut		9. Drilled holes		11. None (open hole)			
2. Louvered shutter		4. Key punched		6. Wire wrapped		<u>8. Saw cut</u>		10. Other (specify)					
SCREEN - PERFORATION INTERVAL		From		50 ft.		to 110 ft.,		From		ft.		to ft.	
		From		ft.		to ft.,		From		ft.		to ft.	
GRAVEL PACK INTERVALS:		From		24 ft.		to 110 ft.,		From		ft.		to ft.	
		From		ft.		to ft.,		From		ft.		to ft.	

6 GROUT MATERIALS:		1. Neat cement		2. Cement Grout		3. Bentonite		Other bentonite hole plug	
Grout Intervals:		From	4 ft.	to	24 ft.,	From	ft.	to	ft.,
What is the nearest source of possible contamination:									
1. Septic tank		4. Lateral lines		7. Pit privy		10. Livestock pens		13. Insecticide storage	
2. Sewer lines		5. Cess Pool		8. Sewage lagoon		11. Fuel storage		14. Abandon water well	
3. Watertight sewer line		6. Seepage pit		9. Feed yard		12. Fertilizer storage		15. Oil well/Gas well	
Direction from well?		East						How many feet? 15	
								16. Other (specify below)	

[illegible]

7 Contractor's or Landowner's Certification: This water well was 1. constructed 2. **reconstructed** or 3. **plugged** under my jurisdiction and was completed on (mo/day/year) **12-21-2004** and this record is true to the best of my knowledge and belief.

Kansas Water Well Contractor's License No. **236** This water well record was completed on (mo/day/year) **12/22/2004**

under the business name of **Harp Well & Pump Service Inc.** by (signature) *J o d d S. H a r p*