

1	LOCATION OF WATER WELL:	Fraction	NE NE SW NW	Section Number	Township Number	Range Number
County:	Sedawick	1/4 1/4	SW 1/4 NE 1/4	15	T 27 S S	R 2 E E/W

Distance and direction from nearest town or city street address of well if located within city?

11518 E. Pinemeadow Ct.


2 WATER WELL OWNER: Philip Vo Nguyen

RR#, St. Address, Box # : 11518 E. Pinemeadow Ct.
City, State, ZIP Code : Wichita, KS 67206

Board of Agriculture, Division of Water Resources
Application Number:

3	LOCATE WELL'S LOCATION WITH	4	DEPTH OF COMPLETED WELL 98 ft. ELEVATION:
---	-----------------------------	---	---

AN "X" IN SECTION BOX:

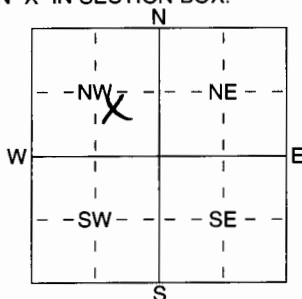

Depth(s) Groundwater Encountered 21 ft. 2 21 ft. 3 21 ft.
WELL'S STATIC WATER LEVEL 21 ft. below land surface measured on mo/day/yr 4/20/05

Pump test data:	Well water was	ft. after	hours pumping	gpm	
Est. Yield	gpm:	Well water was	ft. after	hours pumping	gpm

WELL WATER TO BE USED AS: 5 Public water supply 8 Air conditioning 11 Injection well

1 Domestic	3 Feedlot	6 Oil field water supply	9 Dewatering	12 Other (Specify below)
------------	-----------	--------------------------	--------------	--------------------------

2 Irrigation 4 Industrial 7 Domestic (lawn & garden) 10 Monitoring well


Was a chemical/bacteriological sample submitted to Department? Yes No ~~.....~~; If yes, mo/day/hrs sample was submitted
Water Well Disinfected? Yes ☒ No

5	TYPE OF BLANK CASING USED:
---	----------------------------

5 Wrought iron

8 Concrete tile

CASING JOINTS: Glued ~~.....~~ Clamped

TYPE OF BARRIER CASING USED:

1 Steel	3 RMP (SR)
2 PVC	4 ABS

6 Asbestos-Cement
7 Fiberglass

9 Other (specify below)

Welded

Threaded

Blank casing diameter 5 in. to 98 ft. Dia _____ in. to _____ ft. Dia _____ in. to _____ ft.

Casing height above land surface 16 in., weight 160 lbs./ft. Wall thickness or gauge No. 26

TYPE OF SCREEN OR PERFORATION MATERIAL:

1 Steel	3 Stainless Steel
2 Brass	4 Galvanized Steel

5 Fiberglass
6 Concrete tile

7 PVC
8 RMP (SR)
9 ABS

10 Asbestos-Cement
11 Other (Specify)
12 None used (open hole)

SCREEN OR PERFORATION OPENINGS ARE:

1 Continuous slot 3 Mill slot
2 Louvered shutter 4 Key punched

5 Guazed wrapped
6 Wire wrapped
7 Torch cut

8 Saw cut
9 Drilled holes
10 Other (specify) ft.
11 None (open hole)

SCREEN-PERFORATED INTERVALS: From 30 ft. to 90 ft., From _____ ft. to _____ ft.

From 20 ft. to 30 ft., From _____ ft. to _____ ft.

GRAVEL PACK INTERVALS: From 24 ft. to 90 ft., From _____ ft. to _____ ft.
From _____ ft. to _____ ft., From _____ ft. to _____ ft.

6	GROUT MATERIAL:	1 Neat cement	2 Cement grout	3 Bentonite	4 Other
---	-----------------	---------------	----------------	-------------	---------------

Grout Intervals: From 4 ft. to 24 ft., From ft. to ft., From ft. to ft.

What is the nearest source of possible contamination:

1 Septic tank	4 Lateral lines	7 Pit privy	11 Fuel storage	15 Oil well/Gas well
2 Sewer lines	5 Cess pool	8 Sewage lagoon	12 Fertilizer storage	16 Other (specify below)
3 Watertight sewer lines	6 Seepage pit	9 Feedyard	13 Insecticide storage	

Direction from well? _____ How many feet? _____

[illegible]

7. CONTRACTOR'S OR LANDOWNER'S CERTIFICATION: This water well was (1) constructed, (2) reconstructed, or (3) plugged under my jurisdiction and was completed on (mo/day/year) 4/29/05 and this record is true to the best of my knowledge and belief. Kansas

Water Well Contractor's Licence No 6011 This Water Well Record was completed on (mo/day/yr) 5/1/05
under the business name of Chase Drilling by (signature) Chase