


822 Clear Creek, Wichita

2 WATER WELL OWNER: Jay Sprone
RR#, St. Address, Box # : 822 Clear Creek
City, State, ZIP Code : Wichita, KS

Board of Agriculture, Division of Water Resources
Application Number:

3 LOCATE WELL'S LOCATION WITH AN "X" IN SECTION BOX:

4 DEPTH OF COMPLETED WELL 50 ft. ELEVATION:

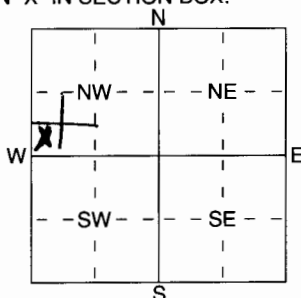

Depth(s) Groundwater Encountered 34 34 ft. 2 _____ ft. 3 _____ ft.
WELL'S STATIC WATER LEVEL 34 ft. below land surface measured on mo/day/yr _____
Pump test data: Well water was _____ ft. after _____ hours pumping _____ gpm
Est. Yield _____ gpm: Well water was _____ ft. after _____ hours pumping _____ gpm
WELL WATER TO BE USED AS:
1 Domestic 3 Feedlot 6 Oil field water supply 8 Air conditioning 11 Injection well
2 Irrigation 4 Industrial 7 Domestic (lawn & garden) 10 Dewatering 12 Other (Specify below)

Was a chemical/bacteriological sample submitted to Department? Yes No; If yes, mo/day/yr sample was submitted
Water Well Disinfected? Yes No

5	TYPE OF BLANK CASING USED:
---	----------------------------

- 1 Steel
2 PVC
3 RMP (SR)
4 ABS

- | | |
|-------------------|-------------------------|
| 5 Wrought iron | 8 Concrete tile |
| 6 Asbestos-Cement | 9 Other (specify below) |
| 7 Fiberglass | |

CASING JOINTS: Glued ☒ Clamped
Welded
Threaded

Blank casing diameter 5 in. to 80 ft., Dia 0 in. to _____ ft., Dia _____ in. to _____ ft.

Casing height above land surface 16 in., weight 160 lbs./ft. Wall thickness or gauge No. 26

TYPE OF SCREEN OR PERFORATION MATERIAL:

- 1 Steel
2 Brass
3 Stainless Steel
4 Galvanized Steel

- | | |
|-----------------|------------|
| 5 Fiberglass | 8 RMP (SR) |
| 6 Concrete tile | 9 ABS |

- 10 Asbestos-Cement
11 Other (Specify)
12 None used (open hole)

SCREEN OR PERFORATION OPENINGS ARE:

- 1 Continuous slot
2 Louvered shutter
3 Mill slot
4 Key punched

- 5 Guazed wrapped
6 Wire wrapped
7 Torch cut

- 8 Saw cut 11 None (open hole)
9 Drilled holes
10 Other (specify) ft.

SCREEN-PERFORATED INTERVALS: From 40 ft. to 80 ft., From _____ ft. to _____ ft.

From ft. to ft., From ft. to ft.

GRAVEL PACK INTERVALS: From 24 ft. to 80 ft., From _____ ft. to _____ ft.

From ft. to ft., From ft. to ft.

6 GROUT MATERIAL: 1 Neat cement 2 Cement grout 3 Bentonite 4 Other

Grout Intervals: From 4 ft. to 24 ft., From _____ ft. to _____ ft., From _____ ft. to _____ ft.

What is the nearest source of possible contamination:

- | | | | | |
|--------------------------|-----------------|-----------------|------------------------|--------------------------|
| 1 Septic tank | 4 Lateral lines | 7 Pit privy | 11 Fuel storage | 15 Oil well/Gas well |
| 2 Sewer lines | 5 Cess pool | 8 Sewage lagoon | 12 Fertilizer storage | 16 Other (specify below) |
| 3 Watertight sewer lines | 6 Seepage pit | 9 Feedyard | 13 Insecticide storage | |

Direction from well?

East

How many feet? 35

[illegible]

7. CONTRACTOR'S OR LANDOWNER'S CERTIFICATION: This water well was (1) constructed, (2) reconstructed, or (3) plugged under my jurisdiction and was completed on (mo/day/year) 7-15-05 and this record is true to the best of my knowledge and belief. Kansas

Water Well Contractor's Licence No. 611 This Water Well Record was completed on (mo/day/yr) 7/19/05
under the business name of Chase Drilling by (signature) [Signature]

INSTRUCTIONS: Use typewriter or ball point pen. PLEASE PRESS FIRMLY and PRINT clearly. Please fill in blanks, underline or circle the correct answers. Send top three copies to Kansas Department of Health and Environment, Bureau of Water, Geology Section, 1000 SW Jackson St., Suite 420, Topeka, Kansas 66612-1367. Telephone 785-296-5522. Send one to WATER WELL OWNER and retain one for your records. Fee of \$5.00 for each constructed well.