

## CORRECTION(S) TO WATER WELL RECORD (WWC-5)

(to rectify lacking or incorrect information)

County: Sedgwick

Location listed as:

Section-Township-Range: 2-21S-2EFraction (  $\frac{1}{4}$   $\frac{1}{4}$   $\frac{1}{4}$ ): SE SW SE

Location changed to:

2-27S-2ESE SW SE

Other changes: Initial statements: \_\_\_\_\_

Changed to: \_\_\_\_\_

Comments: \_\_\_\_\_

verification method: Well address, city street map, position on plat map, and Andover 1:24,000 topo. map.initials: WRL date: 4/11/2006

submitted by: Kansas Geological Survey, Data Resources Library, 1930 Constant Ave., Lawrence, KS 66047-3726

to: Kansas Dept of Health &amp; Environment, Bureau of Water, 1000 SW Jackson, Suite 420, Topeka, KS 66612-1367.

1 LOCATION OF WATER WELL: Fraction Section Number Township Number Range Number  
 County: Sedgwick SE 1/4 SW 1/4 SE 1/4 2 T 21 S R 20 E/W


Distance and direction from nearest town or city street address of well if located within city?

2213 Burning Tree, Wichita

2 WATER WELL OWNER: Brian Bachman  
 RR#, St. Address, Box #: 2213 Burning tree  
 City, State, ZIP Code: Wichita, KS 95  
 Board of Agriculture, Division of Water Resource  
 Application Number:

3 LOCATE WELL'S LOCATION WITH 4 DEPTH OF COMPLETED WELL 95 ft. ELEVATION:

AN "X" IN SECTION BOX:

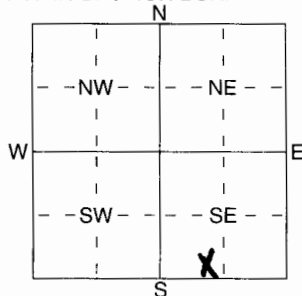

Depth(s) Groundwater Encountered 1 ft. 2 ft. 3 ft.

WELL'S STATIC WATER LEVEL 34 ft. below land surface measured on mo/day/yr

Pump test data: Well water was ..... ft. after ..... hours pumping ..... gpm

Est. Yield ..... gpm: Well water was ..... ft. after ..... hours pumping ..... gpm

WELL WATER TO BE USED AS: 5 Public water supply 8 Air conditioning 11 Injection well

1 Domestic 3 Feedlot 6 Oil field water supply 9 Dewatering 12 Other (Specify below)

2 Irrigation 4 Industrial 7 Domestic (lawn & garden) 10 Monitoring well

Was a chemical/bacteriological sample submitted to Department? Yes ..... No ☒ ; If yes, mo/day/yr sample was submitted  
 Water Well Disinfected? Yes ☒ No

5 TYPE OF BLANK CASING USED: 5 Wrought iron 8 Concrete tile CASING JOINTS: Glued ☒ Clamped

1 Steel 3 RMP (SR) 6 Asbestos-Cement 9 Other (specify below) Welded

PVC 4 ABS 7 Fiberglass Threaded

Blank casing diameter 5 in. to 95 ft. Dia 160 in. to ..... ft. Dia ..... in. to ..... ft.

Casing height above land surface 160 in., weight 160 lbs./ft. Wall thickness or gauge No. 26

TYPE OF SCREEN OR PERFORATION MATERIAL: PVC 10 Asbestos-Cement

1 Steel 3 Stainless Steel 5 Fiberglass 8 RMP (SR) 11 Other (Specify)

2 Brass 4 Galvanized Steel 6 Concrete tile 9 ABS 12 None used (open hole)

SCREEN OR PERFORATION OPENINGS ARE: 5 Gauzed wrapped 8 Saw cut 11 None (open hole)

1 Continuous slot 2 Louvered shutter 4 Mill slot 6 Wire wrapped 9 Drilled holes

2 Key punched 7 Torch cut 10 Other (specify) ..... ft.

SCREEN-PERFORATED INTERVALS: From 55 ft. to 95 ft., From ..... ft. to ..... ft.

GRAVEL PACK INTERVALS: From 24 ft. to 95 ft., From ..... ft. to ..... ft.

From ..... ft. to ..... ft., From ..... ft. to ..... ft.

From ..... ft. to ..... ft., From ..... ft. to ..... ft.

From ..... ft. to ..... ft., From ..... ft. to ..... ft.

6 GROUT MATERIAL: 4 Neat cement 24 Cement grout 3 Bentonite 4 Other

Grout Intervals: From ..... ft. to ..... ft., From ..... ft. to ..... ft., From ..... ft. to ..... ft.

What is the nearest source of possible contamination:

1 Septic tank 4 Lateral lines 7 Pit privy 10 Livestock pens 14 Abandoned water well

2 Sewer lines 5 Cess pool 8 Sewage lagoon 11 Fuel storage 15 Oil well/Gas well

3 Watertight sewer lines 6 Seepage pit 9 Feedyard 12 Fertilizer storage 16 Other (specify below)

Direction from well? NORTH How many feet? 25'

FROM TO LITHOLOGIC LOG FROM TO PLUGGING INTERVALS

0 2 Top Soil 0 2

2 19 Blue Shale 2 19

19 31 Green shale 19 31

31 56 Blue Shale 31 56

56 61 Lime stone 56 61

61 95 Blue Shale 61 95

7 CONTRACTOR'S OR LANDOWNER'S CERTIFICATION: This water well was (1) constructed, (2) reconstructed, or (3) plugged under my jurisdiction and was completed on (mo/day/year) 10/26/95 and this record is true to the best of my knowledge and belief. Kansas

Water Well Contractor's Licence No. 611 This Water Well Record was completed on (mo/day/yr) 11/10/95

under the business name of Chase Drilling by (signature) D. Chase