

1 LOCATION OF WATER WELL:	Fraction	Section Number	Township Number	Range Number
County: <u>Sedgwick</u>	<u>SW 1/4 SW 1/4 NW 1/4</u>	<u>11</u>	T <u>27</u> S <u>0</u>	R <u>20</u> E/W


Distance and direction from nearest town or city street address of well if located within city?

1859 N. Peckham Ct

2 WATER WELL OWNER:	Board of Agriculture, Division of Water Resources
RR#, St. Address, Box # : <u>Shawn Matthews</u>	Application Number:
City, State, ZIP Code : <u>1859 N. Peckham Ct</u>	
<u>Wichita, KS</u>	

3 LOCATE WELL'S LOCATION WITH	4 DEPTH OF COMPLETED WELL	ft. ELEVATION:
-------------------------------	---------------------------	----------------

AN "X" IN SECTION BOX:

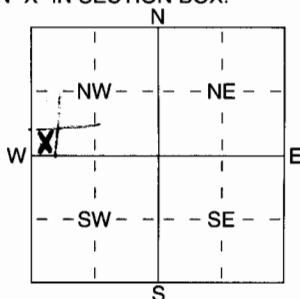

Depth(s) Groundwater Encountered 1..... ft. 2..... ft. 3..... ft.

WELL'S STATIC WATER LEVEL 31..... ft. below land surface measured on mo/day/yr.....

Pump test data: Well water was..... ft. after..... hours pumping..... gpm

Est. Yield..... gpm: Well water was..... ft. after..... hours pumping..... gpm

WELL WATER TO BE USED AS:

1 Domestic 3 Feedlot 5 Public water supply 8 Air conditioning 11 Injection well

2 Irrigation 4 Industrial 6 Oil field water supply 9 Dewatering 12 Other (Specify below)

7 Domestic (lawn & garden) 10 Monitoring well.....

Was a chemical/bacteriological sample submitted to Department? Yes..... No ☒; If yes, mo/day/yr sample was submittedWater Well Disinfected? Yes ☒ No

5 TYPE OF BLANK CASING USED:	5 Wrought iron	8 Concrete tile	CASING JOINTS: Glued <input checked="" type="checkbox"/> Clamped.....
------------------------------	----------------	-----------------	---

1 Steel 3 RMP (SR) 6 Asbestos-Cement 9 Other (specify below) Welded.....

2 PVC 4 ABS 7 Fiberglass Threaded.....

Blank casing diameter..... 5 in. to 90 ft., Dia..... in. to..... ft., Dia..... in. to..... ft.Casing height above land surface..... 160 in., weight..... 160 lbs./ft. Wall thickness or gauge No. 26

TYPE OF SCREEN OR PERFORATION MATERIAL:

1 Steel 3 Stainless Steel 5 Fiberglass 7 PVC 10 Asbestos-Cement

2 Brass 4 Galvanized Steel 6 Concrete tile 8 RMP (SR) 11 Other (Specify).....

12 None used (open hole)

SCREEN OR PERFORATION OPENINGS ARE:

1 Continuous slot 3 Mill slot 5 Guazed wrapped 8 Saw cut 11 None (open hole)

2 Louvered shutter 4 Key punched 6 Wire wrapped 9 Drilled holes

SCREEN-PERFORATED INTERVALS: From..... 50 ft. to..... 90 ft., From..... ft. to..... ft.

From..... ft. to..... ft., From..... ft. to..... ft.

GRAVEL PACK INTERVALS: From..... 25 ft. to..... 90 ft., From..... ft. to..... ft.

From..... ft. to..... ft., From..... ft. to..... ft.

6 GROUT MATERIAL:	1 Neat cement	2 Cement grout	3 Bentonite	4 Other.....
-------------------	---------------	----------------	-------------	--------------

Grout intervals: From..... 4 ft. to..... 24 ft., From..... ft. to..... ft., From..... ft. to..... ft.

What is the nearest source of possible contamination:

1 Septic tank 4 Lateral lines 7 Pit privy 10 Livestock pens 14 Abandoned water well

2 Sewer lines 5 Cess pool 8 Sewage lagoon 11 Fuel storage 15 Oil well/Gas well

3 Watertight sewer lines 6 Seepage pit 9 Feedyard 12 Fertilizer storage 16 Other (specify below)

Direction from well? North How many feet? 38'

FROM	TO	LITHOLOGIC LOG	FROM	TO	PLUGGING INTERVALS
------	----	----------------	------	----	--------------------

0	2	TOP SOIL			
2	6	brown clay			
6	45	yellow shale			
45	82	blue shale			
82	90	blue shale & white limestone			

7 CONTRACTOR'S OR LANDOWNER'S CERTIFICATION: This water well was (1) constructed, (2) reconstructed, or (3) plugged under my jurisdiction and was completed on (mo/day/year)..... <u>6/27/06</u> and this record is true to the best of my knowledge and belief. Kansas Water Well Contractor's Licence No..... <u>611</u> This Water Well Record was completed on (mo/day/yr)..... <u>6/27/06</u> under the business name of <u>Chase Drilling</u> by (signature) <u>D Chase</u>
