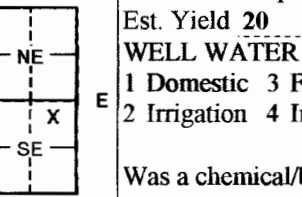


<b>1- LOCATION OF WATER WELL:</b>		Fraction	Section Number		Township Number	Range Number
County: <b>Sedgwick</b>	<b>nw ¼ se ¼ se ¼</b>	<b>2</b>	<b>T 27s S</b>	<b>R 2e E/W</b>		
Distance and direction from nearest town or city street address of well if located within city? <b>14103 E 24<sup>th</sup> ct</b>			<b>Global Positioning System</b> (decimal degrees, min. of 4 digits) Latitude: _____ Longitude: _____ Elevation: _____ Datum: _____ Data Collection Method: _____			
<b>2 WATER WELL OWNER: Pepco Const.</b> RR#, St. Address, Box # : <b>14103 E 24<sup>th</sup> ct</b> City, State, ZIP Code : <b>Wichita, ks 67235</b>						
<b>3 LOCATE WELL'S LOCATION WITH AN "X" IN SECTION BOX:</b>		<b>4 DEPTH OF COMPLETED WELL 85 ft.</b>				
N  S		Depth(s) Groundwater Encountered 1 _____ ft. 2 _____ ft. 3 _____ ft. <b>WELL'S STATIC WATER LEVEL 36</b> ft. below land surface measured on mo/day/yr Pump test data: Well water was _____ ft. after _____ hours pumping _____ gpm Est. Yield <b>20</b> gpm: Well water was _____ ft. after _____ hours pumping _____ gpm <b>WELL WATER TO BE USED AS: 5 Public water supply 8 Air conditioning 11 Injection well</b> <b>1 Domestic 3 Feed lot 6 Oil field water supply 9 Dewatering 12 Other (Specify below)</b> <b>2 Irrigation 4 Industrial ⑦ Domestic (lawn &amp; garden) 10 Monitoring well</b> Was a chemical/bacteriological sample submitted to Department? Yes _____ No <b>x</b> ; If yes, mo/day/yrs _____ Sample was submitted _____ Water Well Disinfected? Yes <b>X</b> No _____				
<b>5 TYPE OF CASING USED:</b>						
1 Steel		3 RMP (SR)		6 Asbestos-Cement		8 Concrete tile
② PVC		4 ABS		7 Fiberglass		CASING JOINTS: Glued <b>X</b> Clamped _____
Blank casing diameter <b>5</b> in. to <b>85</b> ft., Dia		_____ in. to _____ ft., Dia		_____ in. to _____ ft., Dia		Welded _____
Casing height above land surface <b>12</b> in., Weight <b>2.40</b> lbs./ft.		Wall thickness or gauge No. <b>160 psi</b>		Threaded _____		
<b>TYPE OF SCREEN OR PERFORATION MATERIAL:</b>						
1 Steel		3 Stainless steel		5 Fiberglass		⑦ PVC
2 Brass		4 Galvanized steel		6 Concrete tile		8 RM (SR)
SCREEN OR PERFORATION OPENINGS ARE:		1 Continuous slot		③ Mill slot		5 Guaze wrapped
2 Louvered shutter		4 Key punched		6 Wire wrapped		7 Torch cut
SCREEN-PERFORATED INTERVALS:		From <b>45</b> ft. to <b>85</b> ft.		From _____ ft. to _____ ft.		9 Drilled holes
GRAVEL PACK INTERVALS:		From <b>36</b> ft. to <b>85</b> ft.		From _____ ft. to _____ ft.		11 None (open hole)
FROM		TO		LITHOLOGIC LOG		FROM
0		1		Top soil		TO
1		39		Limestone		PLUGGING INTERVALS
39		72		Soft shale		
72		85		Shale		
<b>6 GROUT MATERIAL:</b>						
1 Neat cement		2 Cement grout		③ Bentonite		4 Other _____
Grout Intervals From <b>3</b> ft. to <b>36</b> ft.		From _____ ft. to _____ ft.		From _____ ft. to _____ ft.		From _____ ft. to _____ ft.
What is the nearest source of possible contamination:						
1 Septic tank		4 Lateral lines		7 Pit privy		10 Livestock pens
2 Sewer lines		5 Cess pool		8 Sewage lagoon		11 Fuel storage
③ Watertight sewer lines		6 Seepage pit		9 Feedyard		12 Fertilizer storage
Direction from well? <b>North</b>		How many feet? <b>60</b>		13 Insecticide Storage		16 Other (specify below)
15 Oil well/ gas well						
<b>7 CONTRACTOR'S OR LANDOWNER'S CERTIFICATION:</b> This water well was ① constructed, ② reconstructed, or ③ plugged under my jurisdiction and was completed on (mo/day/year) <b>4-05-08</b> and this record is true to the best of my knowledge and belief.						
Kansas Water Well Contractor's License No. <b>740</b>		This Water Well Record was completed on (mo/day/year) <b>4-21-08</b>				
under the business name of <b>Weninger Drilling Inc.</b>		by (signature) _____				
INSTRUCTIONS: Please fill in blanks or circle the correct answers. Send top three copies to Kansas Department of Health and Environment, Bureau of Water, Geology Section, 1000 SW Jackson St., Suite 420, Topeka, Kansas 66612-1367. Telephone 785-296-9522. Send one to WATER WELL OWNER and retain one for your records. Fee of \$5.00 for each constructed well. Visit us at http://www.kdheks.gov/waterwell.						