

1 LOCATION OF WATER WELL: Fraction NE SW NW SE Section Number 5 Township Number 27 Range Number 2 EW
 County: Sedgwick NW $\frac{1}{4}$ SW $\frac{1}{4}$ SE $\frac{1}{4}$

Distance and direction from nearest town or city street address of well if located within city?

City limits- 9012 Windwood, Wichita, Ks.

2 WATER WELL OWNER: Dr. Badr IedeisRR#, St. Address, Box #: 9012 WindwoodCity, State ZIP Code: Wichita, Ks. 67226

Global Positioning Systems (decimal degrees, min. of 4 digits)

Latitude: _____

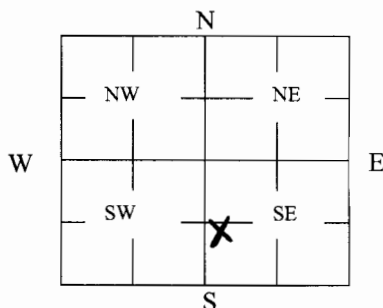
Longitude: _____

Elevation: _____

Datum: _____

Data Collection Method: _____

3 MARK WELL'S LOCATION WITH AN "X" IN SECTION BOX:

4 DEPTH OF WELL 240 ft.X 10

WELL'S STATIC WATER LEVEL _____ ft

WELL WAS USED AS:

1 Domestic

2 Irrigation

3 Feedlot

4 Industrial

5 Public Water Supply

6 Oil Field Water Supply

7 Domestic (Lawn & Garden)

8 Air Conditioning

9 Dewatering

10 Monitoring

11 Injection Well

☒ Other GeothermalWas a chemical/bacteriological sample submitted to Department? Yes _____ No X

5 TYPE OF BLANK CASING USED:

1 Steel

3 RMP (SR)

5 Wrought

7 Fiberglass

☒ Other (Specify below)

2 PVC

4 ABS

6 Asbestos-Cement

8 Concrete Tile

PolyethyleneBlank casing diameter 3/4 in. Was casing pulled? Yes _____ No X If yes, how much _____Casing height above or below land surface 60 in.6 GROUT PLUG MATERIAL: 1 Neat cement 2 Cement grout ☒ Bentonite 4 Other _____Grout Plug Intervals: From 0 ft. to 240 ft., From _____ ft. to _____ ft., From _____ to _____ ft.
X10

What is the nearest source of possible contamination:

1 Septic tank

6 Seepage pit

11 Fuel Storage

16 Other (specify below)

2 Sewer lines

7 Pit privy

12 Fertilizer storage

3 Watertight sewer lines

8 Sewage lagoon

13 Insecticide storage

4 Lateral lines

9 Feedyard

14 Abandoned water well

Direction from well? _____

5 Cess pool

10 Livestock pens

15 Oil well/Gas well

How many feet? _____

FROM	TO	log PLUGGING MATERIALS	FROM	TO	PLUGGING MATERIALS
0	3	Topsoil			
3	19	Clay, tan & brown			
19	92	Shale, gray/soft			
92	97	Limestone, hard			
97	110	Shale, w/limestone layers			
110	112	Fractures			
112	240	Shale, gray & green w/ shale layers			

7 CONTRACTOR'S OR LANDOWNER'S CERTIFICATION: This water well was plugged under my jurisdiction and was completed on (mo/day/year) 12/4/09 and this record is true to the best of my knowledge and belief. Kansas Water Well Contractor's License No. 138. This Water Well Record was completed on (mo/day/year) 12/15/09 under the business name of Peterson Irrigation, Inc. by (signature) Maharaj Peterson

INSTRUCTIONS: Use typewriter or ballpoint pen. Please press firmly and print clearly. Please fill in blanks, underline or circle the correct answers. Send top three copies to Kansas Department of Health and Environment, Bureau of Water, Geology Section, 1000 SW Jackson St., Ste. 420, Topeka, Kansas 66612-1367. Telephone: 785/296-5522. Send one to Water Well Owner and retain one for your records. Visit us at <http://www.kdheks.gov/geo/waterwells>.