

WATER WELL PLUGGING RECORD Form WWC-5P KSA 82a-1212 ID NO.

1 LOCATION OF WATER WELL: County: Sedgwick	Fraction NW ¼ NW ¼ NW ¼	Section Number 11	Township Number 27S	Range Number 2 E
--	-----------------------------------	-----------------------------	-------------------------------	----------------------------

Distance and direction from nearest town or city street address of well if located within city?
Southeast corner of 127th St. E. and 21st St. N. - Wichita

2 WATER WELL OWNER: QuikTrip Corporation

RR#, St. Address, Box #: **PO Box 3475**City, State, ZIP Code: **Tulsa, OK 74101-3475**

Global Positioning System (decimal degrees, min. of 4 digits)

Latitude: _____

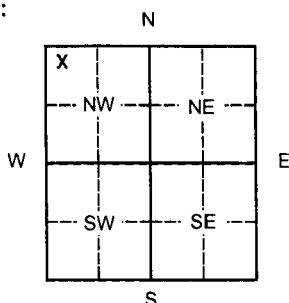
Longitude: _____

Elevation: _____

Datum: _____

Data Collection Method: _____

3 MARK WELL'S LOCATION WITH AN "X" IN SECTION BOX:

4 DEPTH OF WELL **60** ft.WELL'S STATIC WATER LEVEL **40** ft

WELL WAS USED AS:

☒ 1 Domestic☐ 2 Irrigation☐ 3 Feedlot☐ 4 Industrial☐ 5 Public Water Supply☐ 6 Oil Field Water Supply☐ 7 Domestic (Lawn & Garden)☐ 8 Air Conditioning☐ 9 Dewatering☐ 10 Monitoring☐ 11 Injection Well☐ 12 Other _____Was a chemical/bacteriological sample submitted to Department? Yes ___ No ☒ X

5 TYPE OF BLANK CASING USED:

1 Steel

3 RMP (SR)

5 Wrought

7 Fiberglass

9 ☒ Other (Specify below)

2 PVC

4 ABS

6 Asbestos-Cement

8 Concrete Tile

Rock-linedWell diameter **30** in. Was casing pulled? Yes ☒ X No ___ If yes, how much **8'** of rock lining removedCasing height above or below land surface **NA** in.6 GROUT PLUG MATERIAL: 1 Neat cement 2 ☒ Cement grout 3 ☒ Bentonite 4 Other _____Grout Plug Intervals: From **4.5** ft. to **5** ft., From **5** ft. to **30** ft., From _____ to _____ ft.

What is the nearest source of possible contamination:

1 Septic tank

6 Seepage pit

11 Fuel Storage

16 Other (specify below)

2 Sewer lines

7 Pit privy

12 Fertilizer storage

3 Watertight sewer lines

8 Sewage lagoon

13 Insecticide storage

4 Lateral lines

9 Feedyard

14 Abandoned water well

Direction from well?

5 Cess pool

10 Livestock pens

15 Oil well/Gas well

How many feet?

FROM	TO	PLUGGING MATERIALS	FROM	TO	PLUGGING MATERIALS
0.0	4.5	Native Soil (compacted clay)			
4.5	5.0	Bentonite			
5.0	30.0	Concrete Grout			
30.0	60.0	Sand			

7 CONTRACTOR'S OR LANDOWNER'S CERTIFICATION: This water well was plugged under my jurisdiction and was completed on (mo/day/year) **01/22/10** and this record is true to the best of my knowledge and belief. Kansas Water Well Contractor's License No. **531**. This Water Well Record was completed on (mo/day/year) **01/29/10** under the business name of **Geotechnical Services, Inc.** by (signature)

INSTRUCTIONS: Please fill in blanks or circle the correct answers. Send top three copies to Kansas Department of Health and Environment, Bureau of Water, Geology Section, 1000 SW Jackson St., Ste. 420, Topeka, Kansas 66612-1367. Telephone: 785/296-5522. Send one to Water Well Owner and retain one for your records. Visit us at <http://www.kdheks.gov/waterwell>.