

WATER WELL PLUGGING RECORD Form WWC-5P

KSA 82a-1212

ID NO.

0043538

1 LOCATION OF WATER WELL: County: Sedgwick Fraction NE 1/4 NW 1/4 NW 1/4 Section Number 31 Township Number 27 Range Number 20

Distance and direction from nearest town or city street address of well if located within city?

6701 B Harry ST. Wichita KS

2 WATER WELL OWNER: Janyce L. Putnam REV LUTR ETAL Global Positioning Systems (decimal degrees, min. of 4 digits)

RR#, St. Address, Box #:

629 Crest Ridge Court

City, State ZIP Code:

Wichita KS 67230

Latitude: _____


Longitude: _____

Elevation: _____

Datum: _____

Data Collection Method: _____

3 MARK WELL'S LOCATION WITH AN "X" IN SECTION BOX:

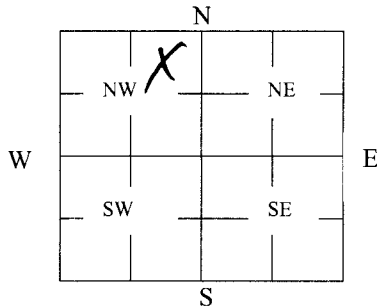

4 DEPTH OF WELL 25.2 ft.

WELL'S STATIC WATER LEVEL 13.81 ft

WELL WAS USED AS:

- 1 Domestic
- 2 Irrigation
- 3 Feedlot
- 4 Industrial

- 5 Public Water Supply
- 6 Oil Field Water Supply
- 7 Domestic (Lawn & Garden)
- 8 Air Conditioning

- 9 Dewatering
- 10 Monitoring
- 11 Injection Well
- 12 Other _____

Was a chemical/bacteriological sample submitted to Department? Yes _____ No X

5 TYPE OF BLANK CASING USED:

- 1 Steel
- 2 PVC

- 3 RMP (SR)
- 4 ABS

- 5 Wrought
- 6 Asbestos-Cement

- 7 Fiberglass
- 8 Concrete Tile

9 Other (Specify below) _____

Blank casing diameter 2 in. Was casing pulled? Yes X No _____ If yes, how much 3'
Casing height above or below land surface 40" in.

6 GROUT PLUG MATERIAL: 1 Neat cement 2 Cement grout 3 Bentonite 4 Other Soil

Grout Plug Intervals: From 25.2 ft. to 1 ft., From 1 ft. to Surface ft., From _____ to _____ ft.

What is the nearest source of possible contamination:

- 1 Septic tank
- 2 Sewer lines
- 3 Watertight sewer lines
- 4 Lateral lines
- 5 Cess pool
- 6 Seepage pit
- 7 Pit privy
- 8 Sewage lagoon
- 9 Feedyard
- 10 Livestock pens
- 11 Fuel Storage
- 12 Fertilizer storage
- 13 Insecticide storage
- 14 Abandoned water well
- 15 Oil well/Gas well

16 Other (specify below) Former fuel storage
Direction from well? NA
How many feet? 0

FROM	TO	PLUGGING MATERIALS	FROM	TO	PLUGGING MATERIALS
<u>25.2</u>	<u>1</u>	<u>Bentonite chips</u>			
<u>1</u>	<u>Surface</u>	<u>Soil</u>			

7 CONTRACTOR'S OR LANDOWNER'S CERTIFICATION: This water well was plugged under my jurisdiction and was completed on (mo/day/year) 4/12/11 and this record is true to the best of my knowledge and belief. Kansas Water Well Contractor's License No. _____ This Water Well Record was completed on (mo/day/year) 4/15/11 under the business name of Tank Management Services by (signature) [Signature]

INSTRUCTIONS: Use typewriter or ballpoint pen. Please press firmly and print clearly. Please fill in blanks, underline or circle the correct answers. Send top three copies to Kansas Department of Health and Environment, Bureau of Water, Geology Section, 1000 SW Jackson St., Ste. 420, Topeka, Kansas 66612-1367. Telephone: 785/296-5522. Send one to Water Well Owner and retain one for your records. Visit us at <http://www.kdheks.gov/geo/waterwells>.