

WATER WELL PLUGGING RECORD Form WWC-5P

KSA 82a-1212


ID NO.

1 LOCATION OF WATER WELL: County: SEDGWICK	Fraction NE 1/4 NW 1/4 NE 1/4	Section Number 20	Township Number 27	Range Number 2 E
--	---	-----------------------------	------------------------------	-----------------------------------

Distance and direction from nearest town or city street address of well if located within city?

WELL IS LOCATED @ #2^N LINDEN, WICHITA, KS 67206

2 WATER WELL OWNER: RED BRICK FINANCIAL, LLC OFFICE RR#, St. Address, Box #: 8020 E. CENTRAL, #150 City, State ZIP Code: WICHITA, KS 67206 (316) 558-5800 DAVID FARHA	Global Positioning Systems (decimal degrees, min. of 4 digits) Latitude: _____ Longitude: _____ Elevation: _____ Datum: _____ Data Collection Method: _____
---	--

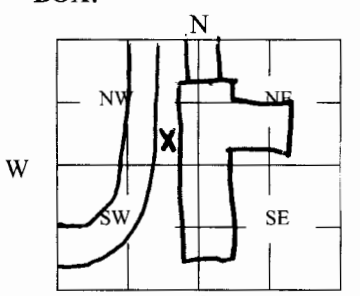3 MARK WELL'S LOCATION WITH AN "X" IN SECTION BOX: 	4 DEPTH OF WELL 21 ft. WELL'S STATIC WATER LEVEL 12.5 ft. WELL WAS USED AS: <table border="0"> <tr> <td>1 Domestic</td> <td>5 Public Water Supply</td> <td>9 Dewatering</td> </tr> <tr> <td>2 Irrigation</td> <td>6 Oil Field Water Supply</td> <td>10 Monitoring</td> </tr> <tr> <td>3 Feedlot</td> <td>7 Domestic (Lawn & Garden)</td> <td>11 Injection Well</td> </tr> <tr> <td>4 Industrial</td> <td>8 Air Conditioning</td> <td>12 Other _____</td> </tr> </table> Was a chemical/bacteriological sample submitted to Department? Yes _____ No X	1 Domestic	5 Public Water Supply	9 Dewatering	2 Irrigation	6 Oil Field Water Supply	10 Monitoring	3 Feedlot	7 Domestic (Lawn & Garden)	11 Injection Well	4 Industrial	8 Air Conditioning	12 Other _____
1 Domestic	5 Public Water Supply	9 Dewatering											
2 Irrigation	6 Oil Field Water Supply	10 Monitoring											
3 Feedlot	7 Domestic (Lawn & Garden)	11 Injection Well											
4 Industrial	8 Air Conditioning	12 Other _____											

5 TYPE OF BLANK CASING USED:

1 Steel	3 RMP (SR)	5 Wrought	7 Fiberglass	9 Other (Specify below)
2 PVC	4 ABS	6 Asbestos-Cement	8 Concrete Tile	

Blank casing diameter **6** in. Was casing pulled? Yes _____ No **X** If yes, how much _____
Casing height above or below land surface **48** in. **(IN CONCRETE VAULT)**

6 GROUT PLUG MATERIAL: 1 Neat cement 2 Cement grout **3 Bentonite** 4 Other _____

Grout Plug Intervals: From **21** ft. to **4** ft., From _____ ft. to _____ ft., From _____ to _____ ft.

What is the nearest source of possible contamination:


1 Septic tank	6 Seepage pit	11 Fuel Storage	16 Other (specify below)
2 Sewer lines	7 Pit privy	12 Fertilizer storage	
3 Watertight sewer lines	8 Sewage lagoon	13 Insecticide storage	
4 Lateral lines	9 Feedyard	14 Abandoned water well	Direction from well? NORTH
5 Cess pool	10 Livestock pens	15 Oil well/Gas well	How many feet? 18

FROM	TO	PLUGGING MATERIALS	FROM	TO	PLUGGING MATERIALS
BOTTOM OF WELL @ (21')	TOP OF CASING @ (4')	BENTONITE			

7 CONTRACTOR'S OR **LANDOWNER'S CERTIFICATION**: This water well was plugged under my jurisdiction and was completed on (mo/day/year) **1/9/12** and this record is true to the best of my knowledge and belief. Kansas Water Well Contractor's License No. **N.A.** This Water Well Record was completed on (mo/day/year) **1/10/12** under the business name of **PROPERTY OWNER** by (signature) **David Farha** **RED BRICK FINANCIAL**

INSTRUCTIONS: Use typewriter or ballpoint pen. Please press firmly and print clearly. Please fill in blanks, underline or circle the correct answers. Send top three copies to Kansas Department of Health and Environment, Bureau of Water, Geology Section, 1000 SW Jackson St., Ste. 420, Topeka, Kansas 66612-1367. Telephone: 785/296-5522. Send one to Water Well Owner and retain one for your records. Visit us at <http://www.kdheks.gov/geo/waterwells>.

FRONT (WEST) SIDE OF HOUSE

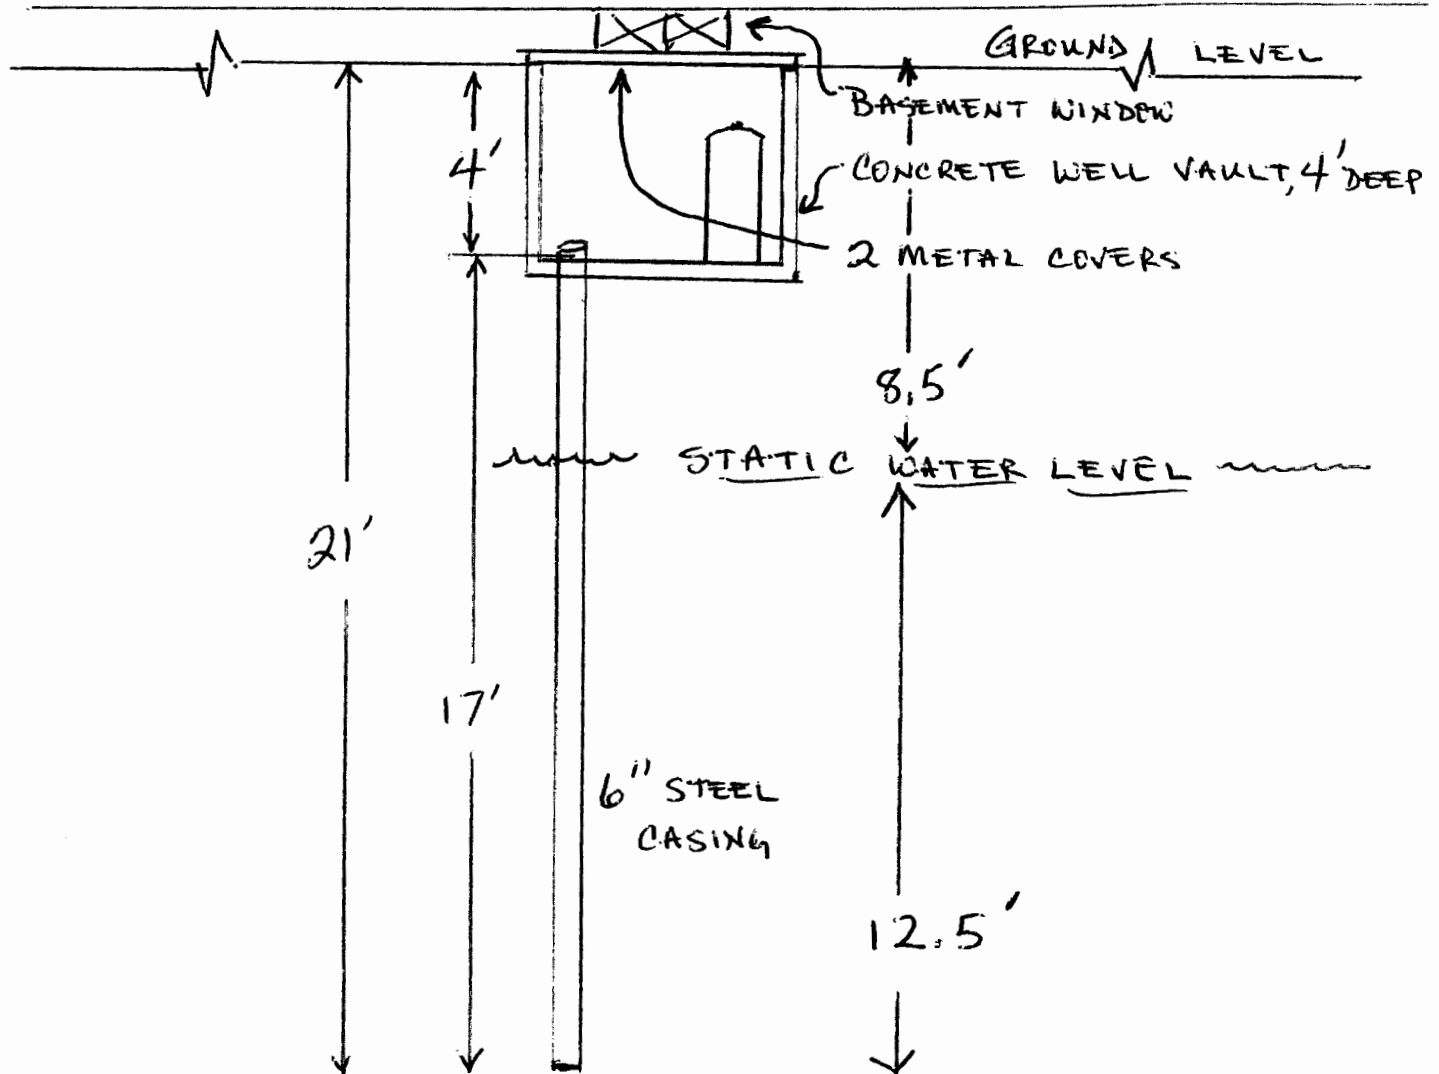

#2 LINDEN
WICHITA, KS 67206
SEDGWICK COUNTY

1/10/2012



Mail Payments to:
M6 Concrete Accessories
1030 South McComas
Wichita, KS 67213
(316) 263-7251
Fax (316) 267-7971
www.conacc.com

INVOICE

INVOICE NUMBER: 0668163-IN
INVOICE DATE: 1/9/2012
ORDER NUMBER:
ORDER DATE:
CUSTOMER NUMBER: 0000001
Page 1

CASH OR CREDIT CARD SALES

SHIP TO:
CASH OR CREDIT CARD SALES

CONFIRM TO:

TAX EXEMPTION NUMBER:

CUSTOMER P.O.	SHIP VIA	TERMS
---------------	----------	-------

WILLCALL

DUE UPON RECEIPT

ITEM #	DESCRIPTION	ORDERED	SHIPPED	U/M	UNIT COST	AMOUNT
1103	BENTONITE 100#	1.000	1.000	EA	17.3125	17.31 TX

CASH
JLP

Returns subject to M6 Concrete Accessories approval
Restocking Charges and freight costs may apply.
No returns on special order items.



Contract Holder
Wichita, KS 67213-1000

Net Invoice: 17.31
Freight: 0.00
Wichita Sales Tax: 1.26
Invoice Total: 18.57

Received By: _____

INFOTRAC EMERGENCY RESPONSE PHONE # 1-800-535-5053