

County: Sedgwick Fraction SE SW NE NE Sec. 22 T 27 S R 2 EW

CORRECTION(S) TO WATER WELL COMPLETION RECORD (WWC-5)

(to rectify lacking or incorrect information)

Owner: Mrs. Murry

Location was listed as:

Section-Township-Range: 22-27S-2E

Fraction ($\frac{1}{4}$ $\frac{1}{4}$ $\frac{1}{4}$): NE NE NE

Location changed to:

22-27S-2E

SE SW NE NE

Other changes: Initial statements: _____

Changed to: _____

Comments: _____

Verification method: wellsite address, city street map, and mapping tool on KGS website.

initials: ARA date: 7/27/2015

Submitted by: Kansas Geological Survey, Data Resources Library, 1930 Constant Ave., Lawrence, KS 66047-3726

to: Kansas Dept of Health & Environment, Bureau of Water, 1000 SW Jackson, Suite 420, Topeka, KS 66612-1367.

WATER WELL PLUGGING RECORD Form WWC-5P

KSA 82a-1212

ID NO.

1 LOCATION OF WATER WELL: County: Seawich Fraction NE 1/4 NE 1/4 NE 1/4 Section Number 22 Township Number 27 Range Number 2 EW

Distance and direction from nearest town or city street address of well if located within city?

329 Barnett

2 WATER WELL OWNER:

mrs murray
RR#, St. Address, Box #: 329 Barnett

City, State ZIP Code:

wichita Ks
67206

Global Positioning Systems (decimal degrees, min. of 4 digits)

Latitude: _____

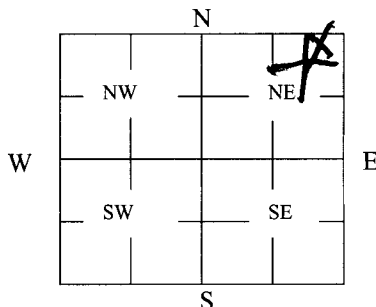
Longitude: _____

Elevation: _____

Datum: _____

Data Collection Method: _____

3 MARK WELL'S LOCATION WITH AN "X" IN SECTION BOX:

4 DEPTH OF WELL 40 ft.WELL'S STATIC WATER LEVEL no water in well ft.

WELL WAS USED AS:

1 Domestic

2 Irrigation

3 Feedlot

4 Industrial

5 Public Water Supply

6 Oil Field Water Supply

7 Domestic (Lawn & Garden)

8 Air Conditioning

9 Dewatering

10 Monitoring

11 Injection Well

12 Other _____

Was a chemical/bacteriological sample submitted to Department? Yes _____ No X

5 TYPE OF BLANK CASING USED:

1 Steel
2 PVC

3 RMP (SR)
4 ABS

5 Wrought

6 Asbestos-Cement

7 Fiberglass

8 Concrete Tile

9 Other (Specify below) _____

Blank casing diameter 5 in. Was casing pulled? Yes _____ No X If yes, how much _____Casing height above or below land surface 6 in.

6 GROUT PLUG MATERIAL:

1 Neat cement

2 Cement grout

3 Bentonite

4 Other _____

Grout Plug Intervals: From 20 ft. to 0 ft., From _____ ft. to _____ ft., From _____ to _____ ft.

What is the nearest source of possible contamination:

1 Septic tank

6 Seepage pit

11 Fuel Storage

16 Other (specify below) _____

2 Sewer lines

7 Pit privy

12 Fertilizer storage

3 Watertight sewer lines

8 Sewage lagoon

13 Insecticide storage

4 Lateral lines

9 Feedyard

14 Abandoned water well

Direction from well? East

5 Cess pool

10 Livestock pens

15 Oil well/Gas well

How many feet? 50

FROM	TO	PLUGGING MATERIALS	FROM	TO	PLUGGING MATERIALS
<u>40</u>	<u>20</u>	<u>Sand & Gravel</u>			
<u>20</u>	<u>0</u>	<u>Cement grout</u>			

7 CONTRACTOR'S OR LANDOWNER'S CERTIFICATION: This water well was plugged under my jurisdiction and was completed on (mo/day/year) 12-22-11 and this record is true to the best of my knowledge and belief. Kansas Water Well Contractor's License No. 472 This Water Well Record was completed on (mo/day/year) 12-28-11 under the business name of Beardon Pump & Well (signature) David Beardon

INSTRUCTIONS: Use typewriter or ballpoint pen. Please press firmly and print clearly. Please fill in blanks, underline or circle the correct answers. Send top three copies to Kansas Department of Health and Environment, Bureau of Water, Geology Section, 1000 SW Jackson St., Ste. 420, Topeka, Kansas 66612-1367. Telephone: 785/296-5522. Send one to Water Well Owner and retain one for your records. Visit us at <http://www.kdheks.gov/geo/waterwells>.