

County: Sedgwick Fraction NW NW SW NW Sec. 7 T 27 S R 2 EW

CORRECTION(S) TO WATER WELL COMPLETION RECORD (WWC-5)

(to rectify lacking or incorrect information)

Owner: Perry Duncan (Spring Clean Laundry)

Location was listed as:

Section-Township-Range: None Given

Fraction ($\frac{1}{4}$ $\frac{1}{4}$ $\frac{1}{4}$): _____

Location changed to:

7-27 S-2 E

NW NW SW NW

Other changes: Initial statements: _____

Changed to: _____

Comments: Latitude & longitude believed to be off a bit, puts it in
SE SE SW SW of this section, which does not agree with street address.

Verification method: Well site address, city street map, and
mapping tool on KGS website.

Submitted by: Kansas Geological Survey, Data Resources Library, 1930 Constant Ave., Lawrence, KS 66047-3726
to: Kansas Dept of Health & Environment, Bureau of Water, 1000 SW Jackson, Suite 420, Topeka, KS 66612-1367.

initials: DR date: 11/8/2012

--

Check: ☒ White Copy, ☐ Blue Copy, ☐ Pink Copy

TOTAL SERVICE CO. PONTOTOC, INC.

P.O. BOX 818 / 425 HALLMAN TRAIL

PONTOTOC, MS 38863


PHONE & FAX 662-841-0251

Perry Duncan

Spring Clean Laundry

1930 N Woodlawn Wichita KS 67208

O 2-12 1-1 0
O 2-11 1-2-0
O 2-10 1-3-0
O 2-9 1-4-0
O 2-8 1-5-0
O 2-7 1-6-0

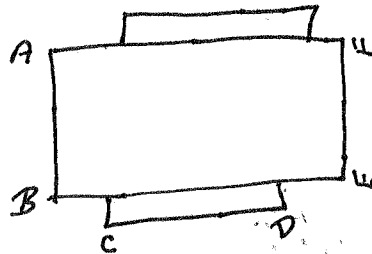

O 2-1 0 2-12
O 2-2 0 2-11
O 2-3 0 2-10
O 2-4 0 2-9
O 2-5 0 2-8
O 2-6 0 2-7

O O O O O O O
1-1 1-1 1-1 1-1 1-1 1-1 1-1

O O O O O
8-7 6-7 2-10 11-7 2-12

37° 42' 31" N
97° 15' 31" W

Woodlawn Rd.

<u>A</u>	<u>B</u>	<u>C</u>	<u>D</u>	<u>E</u>	<u>F</u>
2-1-31	100	2-1 115	22	2-1 95	55
2-2-21	83	2-2 94	32	2-2 75	73
2-3-24	63	2-3 74	50	2-3 55	92
2-4-45	44	2-4 54	70	2-4 38	112
2-5-68	33	2-5 36	90	2-5 25	131
2-6-87	35	2-6 23	108	2-6 30	155
2-7-96	57	2-7 24	129	2-7 46	157
2-8-17	56	2-8 51	152	2-8 45	137
2-9-60	62	2-9 42	129	2-9 51	121
2-10-47	77	2-10 44	110	2-10 65	103
2-11-44	94	2-11 52	95	2-11 83	84
	108	2-12 1.7	76		70