


WATER WELL RECORD Form WWC-5 KSA 82a-1212

1 LOCATION OF WATER WELL: Sedgwick	FRACTION NE 1/4 NW 1/4 SE 1/4	SECTION NUMBER 12	TOWNSHIP NUMBER T 27 S	RANGE NUMBER R 2E EW
--	---	-----------------------------	----------------------------------	--------------------------------

Distance and direction from nearest town or city street address of well if located within city?
15413 E. Sundance Wichita, Kansas

2 WATER WELL OWNER: FAHSOLTZ CONSTRUCTION	Board of Agriculture, Division of Water Resource
RR#, ST. ADDRESS, BOX #: 2085 N. Glenwood Ct.	Application Number:
CITY, STATE: Wichita, Kansas	ZIP CODE:

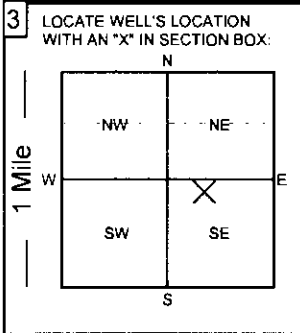

4 DEPTH OF COMPLETED WELL: 116 ft.	ELEVATION:
Depth of groundwater Encountered: _____ ft.	_____ ft.
WELL'S STATIC WATER LEVEL 42 FT. BELOW LAND SURFACE MEASURED ON 2/25/14	mo/day/yr:
Pump test data: Well water was _____ ft. after _____ hours of pumping @ _____ gpm	
Est. Yield: _____ gpm Well water was _____ ft. after _____ hours of pumping @ _____ gpm	
Bore Hole Diameter 12 in. to 116 ft. and _____ in. to _____ ft.	
WELL WATER TO BE USED AS:	
1. Domestic 3. Feedlot 5. Public water supply <u>7. Lawn and garden only</u> 9. Dewatering 11. Injection well	12. Other (Specify below)
2. Irrigation 4. Industrial 6. Oil field water supply 8. Air conditioning 10. Monitoring well	
Was a chemical/bacteriological sample submitted to Department? YES <u>NO</u> ; if yes, what mo/day/yr was sample submitted	
Was Water Well Disinfected? <u>YES</u> NO	

5 TYPE OF CASING USED:	1. Steel	3. RPM (SR)	5. Wrought Iron	7. Fiberglass	9. Other (Specify below)	CASING JOINTS: <u>Glued</u> Threaded
<u>2. PVC</u>	4. ABS	6. Asbestos-Cement	8. Concrete tile	SDR-26	Welded	Clamped
Blank casing diameter 5 in. to 50 ft., Dia. _____ in. to _____ ft., Dia. _____ in. to _____ ft.						
Casing height above land surface: 12 in., Weight: 2.35 lbs. / ft. Wall thickness or gauge No. .214						
TYPE OF SCREEN OR PERFORATION MATERIAL:	1. Steel	3. Stainless Steel	5. Fiberglass	<u>7. PVC</u>	9. ABS	11. Other (specify)
2. Brass	4. Galvanized	6. Concrete Tile	8. RMP (SR)	10. Asbestos-Cement	12. None used (open hole)	
SCREEN OR PERFORATION OPENINGS ARE:	1. Continuous slot	3. Mill slot	5. Gauzed wrapped	7. Torch cut	9. Drilled holes	11. None (open hole)
2. Louvered shutter	4. Key punched	6. Wire wrapped	<u>8. Saw cut</u>	10. Other (specify)		
SCREEN - PERFORATION INTERVAL	From 50 ft. to 116 ft.,	From _____ ft. to _____ ft.	From _____ ft. to _____ ft.	From _____ ft. to _____ ft.		
GRAVEL PACK INTERVALS:	From 24 ft. to 116 ft.,	From _____ ft. to _____ ft.	From _____ ft. to _____ ft.	From _____ ft. to _____ ft.		

6 GROUT MATERIALS:	1. Neat cement	2. Cement Grout	3. Bentonite	Other bentonite hole plug		
Grout Intervals: From 4 ft. to 24 ft., From _____ ft. to _____ ft., From _____ ft. to _____ ft.						
What is the nearest source of possible contamination:	1. Septic tank	4. Lateral lines	7. Pit privy	10. Livestock pens	13. Insecticide storage	15. Oil well/Gas well
2. Sewer lines	5. Cess Pool	8. Sewage lagoon	11. Fuel storage	14. Abandon water well	16. Other (specify below)	
<u>3. Watertight sewer line</u>	6. Seepage pit	9. Feed yard	12. Fertilizer storage			
Direction from well? West				How many feet? 10 ft. plus		

From	To	LITHOLOGIC LOG	From	To	LITHOLOGIC LOG
0	3	topsoil			
3	25	clay			
25	110	grey shale			
110	116	limestone			

7 Contractor's or Landowner's Certification: This water well was 1. <u>constructed</u> 2. reconstructed or 3. plugged under my jurisdiction and was completed on (mo/day/year) 2/25/2014 and this record is true to the best of my knowledge and belief.
Kansas Water Well Contractor's License No. 236 This water well record was completed on (mo/day/year) 2/27/2014
under the business name of Harp Well and Pump Service by (signature) Todd S. Harp