


WATER WELL RECORD Form WWC-5 KSA 82a-1212

1 LOCATION OF WATER WELL: Sedgwick	FRACTION SE 1/4 SE 1/4 NE 1/4	SECTION NUMBER 11	TOWNSHIP NUMBER T 27 S	RANGE NUMBER R 2E E/W
---	---	-----------------------------	----------------------------------	---------------------------------

Distance and direction from nearest town or city street address of well if located within city?
1816 N. Split Rail Ct. Wichita, Kansas 67230

2 WATER WELL OWNER: RR#.ST. ADDRESS,BOX #: CITY, STATE:	NIES CONSTRUCTION 10333 E. 21st #303 Valley Center, Kansas	Board of Agriculture, Division of Water Resource Application Number:
	ZIP CODE:	

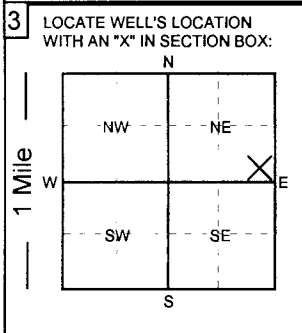

4 DEPTH OF COMPLETED WELL: 73 ft.	ELEVATION:
Depth of groundwater Encountered: _____ ft.	
WELL'S STATIC WATER LEVEL 45 FT. BELOW LAND SURFACE MEASURED ON 5/16/14	
Pump test data: Well water was _____ ft. after _____ hours of pumping @ _____ gpm	
Est. Yield: _____ gpm Well water was _____ ft. after _____ hours of pumping @ _____ gpm	
Bore Hole Diameter 12 in. to 73 ft. and _____ in. to _____ ft.	
WELL WATER TO BE USED AS:	
1. Domestic 3. Feedlot 5. Public water supply <u>7. Lawn and garden only</u> 9. Dewatering 11. Injection well	
2. Irrigation 4. Industrial 6. Oil field water supply 8. Air conditioning 10. Monitoring well 12. Other (Specify below)	
Was a chemical/bacteriological sample submitted to Department? YES <u>NO</u> ; If yes, what mo/day/yr was sample submitted _____	
Was Water Well Disinfected? <u>YES</u> NO	

5 TYPE OF CASING USED:	CASING JOINTS: <u>Glued</u> Threaded
1. Steel 3. RPM (SR) 5. Wrought Iron 7. Fiberglass 9. Other (Specify below)	Welded Clamped
<u>2. PVC</u> 4. ABS	SDR-26
Blank casing diameter 5 in. to 40 ft., Dia. _____ in. to _____ ft., Dia. _____ in. to _____ ft.	
Casing height above land surface: 12 in., Weight: 2.35 lbs. / ft. Wall thickness or gauge No. .214	
TYPE OF SCREEN OR PERFORATION MATERIAL:	
1. Steel 3. Stainless Steel 5. Fiberglass <u>7. PVC</u> 9. ABS 11. Other (specify)	
2. Brass 4. Galvanized 6. Concrete Tile 8. RMP (SR) 10. Asbestos-Cement 12. None used (open hole)	
SCREEN OR PERFORATION OPENINGS ARE:	
1. Continuous slot 3. Mill slot 5. Gauzed wrapped 7. Torch cut 9. Drilled holes 11. None (open hole)	
2. Louvered shutter 4. Key punched 6. Wire wrapped <u>8. Saw cut</u> 10. Other (specify)	
SCREEN - PERFORATION INTERVAL From 40 ft. to 73 ft., From _____ ft. to _____ ft.	
GRAVEL PACK INTERVALS: From 24 ft. to 73 ft., From _____ ft. to _____ ft.	

6 GROUT MATERIALS:	1. Neat cement 2. Cement Grout 3. Bentonite Other bentonite hole plug
Grout Intervals: From 4 ft. to 24 ft., From _____ ft. to _____ ft., From _____ ft. to _____ ft.	
What is the nearest source of possible contamination:	
1. Septic tank 4. Lateral lines 7. Pit privy 10. Livestock pens 13. Insecticide storage 15. Oil well/Gas well	
2. Sewer lines 5. Cess Pool 8. Sewage lagoon 11. Fuel storage 14. Abandon water well 16. Other (specify below)	
<u>3. Watertight sewer line</u> 6. Seepage pit 9. Feed yard 12. Fertilizer storage	
Direction from well? East How many feet? 10 ft. plus	

From	To	LITHOLOGIC LOG	From	To	LITHOLOGIC LOG
0	3	topsoil			
3	8	clay			
8	73	gray shale			

7 Contractor's or Landowner's Certification: This water well was 1. <u>constructed</u> 2. reconstructed or 3. plugged under my jurisdiction and was completed on (mo/day/year) 5/16/14 and this record is true to the best of my knowledge and belief.	This water well record was completed on (mo/day/year) 5/19/14
Kansas Water Well Contractor's License No. 236 under the business name of Harp Well and Pump Service	by (signature) Todd S. Harp