


**WATER WELL RECORD Form WWC-5 KSA 82a-1212**

<b>1</b> LOCATION OF WATER WELL: <b>Sedgwick</b>	FRACTION <b>NE 1/4 SE 1/4 SE 1/4</b>	SECTION NUMBER <b>1</b>	TOWNSHIP NUMBER <b>T 27 S</b>	RANGE NUMBER <b>R 2E E/W</b>
---	---	----------------------------	----------------------------------	---------------------------------

Distance and direction from nearest town or city street address of well if located within city?  
**15923 E. Boxthorn Wichita, Kansas**

<b>2</b> WATER WELL OWNER: <b>SHARP HOMES</b>	Board of Agriculture, Division of Water Resource
RR#,ST. ADDRESS,BOX #: <b>430 Walnut</b>	ZIP CODE: <b>67010</b>
CITY, STATE: <b>Augusta, Kansas</b>	Application Number: _____

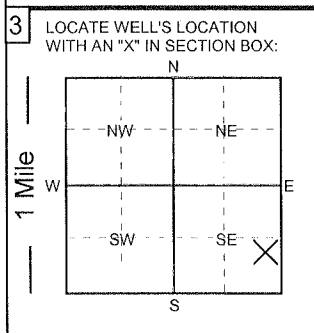

**4** DEPTH OF COMPLETED WELL: **110** ft. ELEVATION: \_\_\_\_\_ ft.

Depth of groundwater Encountered: \_\_\_\_\_ ft.

WELL'S STATIC WATER LEVEL **45** FT. BELOW LAND SURFACE MEASURED ON **8/27/14** mo/day/yr:

Pump test data: Well water was \_\_\_\_\_ ft. after \_\_\_\_\_ hours of pumping @ \_\_\_\_\_ gpm

Est. Yield: \_\_\_\_\_ gpm Well water was \_\_\_\_\_ ft. after \_\_\_\_\_ hours of pumping @ \_\_\_\_\_ gpm

Bore Hole Diameter **12** in. to **110** ft. and \_\_\_\_\_ in. to \_\_\_\_\_ ft.

WELL WATER TO BE USED AS:

1. Domestic 3. Feedlot 5. Public water supply **7. Lawn and garden only** 9. Dewatering 11. Injection well  
 2. Irrigation 4. Industrial 6. Oil field water supply 8. Air conditioning 10. Monitoring well 12. Other (Specify below)

Was a chemical/bacteriological sample submitted to Department? **YES**  **NO** ; If yes, what mo/day/yr was sample submitted \_\_\_\_\_

Was Water Well Disinfected?  **YES**  **NO**

**5** TYPE OF CASING USED:

1. Steel	3. RPM (SR)	5. Wrought Iron	7. Fiberglass	9. Other (Specify below)	CASING JOINTS: <input checked="" type="radio"/> <b>Glued</b> <input type="radio"/> Threaded
<input checked="" type="radio"/> <b>2. PVC</b>	4. ABS	6. Asbestos-Cement	8. Concrete tile	<b>SDR-26</b>	<input type="radio"/> Welded <input type="radio"/> Clamped

Blank casing diameter **5** in. to **50** ft., Dia. in. to ft., Dia. in. to ft.

Casing height above land surface: **12** in., Weight: **2.35** lbs. / ft. Wall thickness or gauge No. **.214**

TYPE OF SCREEN OR PERFORATION MATERIAL:

1. Steel	3. Stainless Steel	5. Fiberglass	<input checked="" type="radio"/> <b>7. PVC</b>	9. ABS	11. Other (specify)
2. Brass	4. Galvanized	6. Concrete Tile	8. RMP (SR)	10. Asbestos-Cement	12. None used (open hole)

SCREEN OR PERFORATION OPENINGS ARE:

1. Continuous slot	3. Mill slot	5. Gauzed wrapped	7. Torch cut	9. Drilled holes	11. None ( open hole)
2. Louvered shutter	4. Key punched	6. Wire wrapped	<input checked="" type="radio"/> <b>8. Saw cut</b>	10. Other (specify)	

SCREEN - PERFORATION INTERVAL

From <b>50</b> ft.	to <b>110</b> ft.,	From _____ ft.	to _____ ft.
From _____ ft.	to _____ ft.,	From _____ ft.	to _____ ft.

GRAVEL PACK INTERVALS:

From <b>24</b> ft.	to <b>110</b> ft.,	From _____ ft.	to _____ ft.
From _____ ft.	to _____ ft.,	From _____ ft.	to _____ ft.

**6** GROUT MATERIALS: 1. Neat cement 2. Cement Grout 3. Bentonite Other **bentonite hole plug**

Grout Intervals: From **4** ft. to **24** ft., From \_\_\_\_\_ ft. to \_\_\_\_\_ ft., From \_\_\_\_\_ ft. to \_\_\_\_\_ ft.

What is the nearest source of possible contamination:

1. Septic tank	4. Lateral lines	7. Pit privy	10. Livestock pens	13. Insecticide storage	15. Oil well/Gas well
2. Sewer lines	5. Cess Pool	8. Sewage lagoon	11. Fuel storage	14. Abandon water well	16. Other (specify below)
<input checked="" type="radio"/> <b>3. Watertight sewer line</b>	6. Seepage pit	9. Feed yard	12. Fertilizer storage		

Direction from well? **North** How many feet? **10 ft. plus**

From	To	LITHOLOGIC LOG	From	To	LITHOLOGIC LOG
<b>0</b>	<b>3</b>	<b>topsoil</b>			
<b>3</b>	<b>20</b>	<b>clay</b>			
<b>20</b>	<b>105</b>	<b>gray shale</b>			
<b>105</b>	<b>110</b>	<b>limestone</b>			

**7** Contractor's or Landowner's Certification: This water well was **1. constructed** 2. reconstructed or 3. plugged under my jurisdiction and was completed on (mo/day/year) **8/27/2014** and this record is true to the best of my knowledge and belief.

Kansas Water Well Contractor's License No. **236** This water well record was completed on (mo/day/year) **8/29/2014**

under the business name of **Harp Well and Pump Service** by (signature) *Todd S. Harp*