

Division of Water Resources App. No.

KSA 82a-1212

Check: ☒ White Copy, ☐ Blue Copy, ☐ Pink Copy

1224 S. Webb Rd. Wichita Ks.

A 1. 185

2. 166

3. 145

4. 125

5. 106

6. 87

7. 68

8. 51

9. 36

10. 28

B 1. 45

2. 33

3. 29

4. 37

5. 53

6. 71

7. 89

8. 108


9. 128

10. 147

G.P.S. Heading going into Building

N. $37^{\circ} 40' 16''$

W. $97^{\circ} 13' 10''$

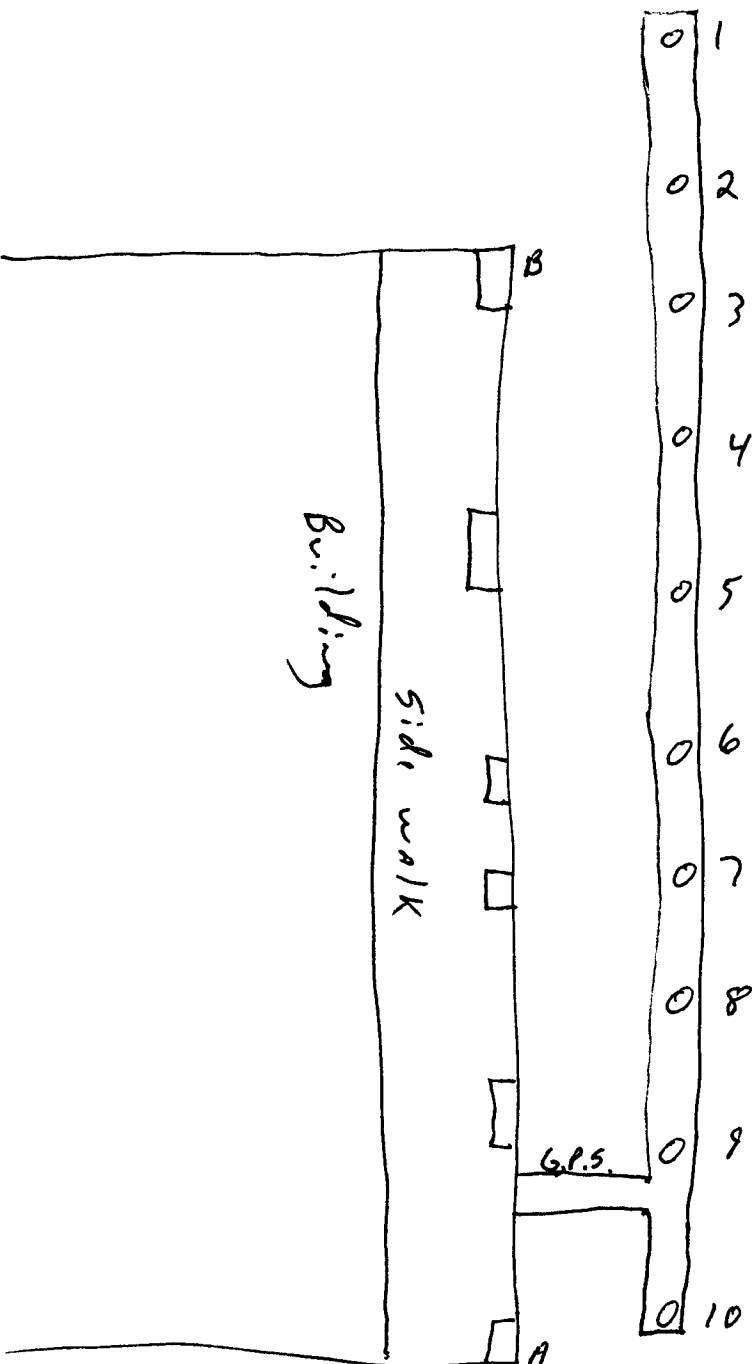

County: Sedgwick Fraction NW NW SW Sec. 28 T 27 S R 2 EW

CORRECTION(S) TO WATER WELL COMPLETION RECORD (WWC-5)

(to rectify lacking or incorrect information)

Owner: Perry Duncan

Location was listed as:

Location changed to:

Section-Township-Range: None Given

28-27S-2E

Fraction ($\frac{1}{4}$ $\frac{1}{4}$ $\frac{1}{4}$):

NW NW SW

Other changes: Initial statements: Longitude: W. 97° 13' 10"

Changed to: Longitude: 97° 13' 30" W

Comments:

Verification method: well site address, city street map, corrected latitude & longitude, KGS' "LEO" conversion tool, and mapping tool on KGS website.

initials: DRB date: 11/24/2014

Submitted by: Kansas Geological Survey, Data Resources Library, 1930 Constant Ave., Lawrence, KS 66047-3726

to: Kansas Dept of Health & Environment, Bureau of Water, 1000 SW Jackson, Suite 420, Topeka, KS 66612-1367.