

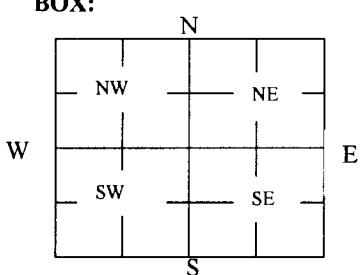
WATER WELL PLUGGING RECORD Form WWC-5P

KSA 82a-1212

ID NO.

KMW-6

1 LOCATION OF WATER WELL: County: <u>sedgwick</u>	Fraction SW 1/4 SW 1/4 SW 1/4 1/4	Section Number 21	Township Number T 27 S	Range Number 2 ☒ E ☐ W
Street/Rural Address of Well Location; if unknown, distance & direction from nearest town or intersection: If at owner's address, check here ☐ northeast corner of kellogg and webb		Global Positioning Systems (GPS) information: Latitude: <u>N 37.680583</u> (in decimal degrees) Longitude: <u>W 97.225547</u> (in decimal degrees) Elevation: _____ Datum: ☐ WGS84, ☐ NAD83, ☐ NAD27 Collection Method: ☐ GPS unit (Make/Model: _____) ☐ Digital Map/Photo, ☐ Topographic Map, ☐ Land Survey Est. Accuracy: ☐ < 3 m, ☐ 3-5 m, ☐ 5-15 m, ☐ > 15 m		
2 WATER WELL OWNER: Hawker Beechcraft RR#, St. Address, Box #: 101 S. Webb Rd. City, State ZIP Code: Wichita KS 67207				

3 MARK WELL'S LOCATION WITH AN "X" IN SECTION BOX: 	4 DEPTH OF WELL <u>35</u> ft. WELL'S STATIC WATER LEVEL _____ ft. WELL WAS USED AS: <table border="0"> <tr> <td>☐ Domestic</td> <td>☐ Public Water Supply</td> <td>☐ Dewatering</td> </tr> <tr> <td>☐ Irrigation</td> <td>☐ Oil Field Water Supply</td> <td>☒ Monitoring</td> </tr> <tr> <td>☐ Feedlot</td> <td>☐ Domestic (Lawn & Garden)</td> <td>☐ Injection Well</td> </tr> <tr> <td>☐ Industrial</td> <td>☐ Air Conditioning</td> <td>☐ Other _____</td> </tr> </table> Was a chemical/bacteriological sample submitted to Department? Yes ☐ No ☒	☐ Domestic	☐ Public Water Supply	☐ Dewatering	☐ Irrigation	☐ Oil Field Water Supply	☒ Monitoring	☐ Feedlot	☐ Domestic (Lawn & Garden)	☐ Injection Well	☐ Industrial	☐ Air Conditioning	☐ Other _____

5 TYPE OF BLANK CASING USED:

☐ Steel ☐ RMP (SR) ☐ Wrought ☐ Fiberglass ☐ Other (Specify below)
☒ PVC ☐ ABS ☐ Asbestos-Cement ☐ Concrete Tile

Blank casing diameter 2 in. Was casing pulled? Yes ☒ No ☐ If yes, how much 5
Casing height above or below land surface 0 in.

6 GROUT PLUG MATERIAL: ☐ Neat cement ☐ Cement grout ☒ Bentonite ☐ Other _____

Grout Plug Intervals: From 35 ft. to 5 ft., From _____ ft. to _____ ft., From _____ to _____ ft.

What is the nearest source of possible contamination:

☐ Septic tank	☐ Seepage pit	☐ Fuel Storage	☐ Other (specify below)
☐ Sewer lines	☐ Pit privy	☐ Fertilizer storage	
☐ Watertight sewer lines	☐ Sewage lagoon	☐ Insecticide storage	
☐ Lateral lines	☐ Feedyard	☐ Abandoned water well	Direction from well? _____
☐ Cess pool	☐ Livestock pens	☐ Oil well/Gas well	How many feet? _____

FROM	TO	PLUGGING MATERIALS	FROM	TO	PLUGGING MATERIALS
35	5	bentonite chips	5	0	soil

7 CONTRACTOR'S OR LANDOWNER'S CERTIFICATION: This water well was plugged under my jurisdiction and was completed on (mo/day/year) 10/20/14 and this record is true to the best of my knowledge and belief. Kansas Water Well Contractor's License No. 709. This Water Well Record was completed on (mo/day/year) 11/1/14 under the business name of Plains Environmental Services by (signature) Jesse Kalvig

INSTRUCTIONS: Use typewriter or ballpoint pen. Please press firmly and print clearly. Please fill in blanks, underline or circle the correct answers. Send one copy to Kansas Department of Health and Environment, Bureau of Water, Geology Section, 1000 SW Jackson St., Ste. 420, Topeka, Kansas 66612-1367. Telephone: 785/296-5524. Send one to Water Well Owner and retain one for your records. Visit us at <http://www.kdheks.gov/waterwell/index.html>.