


WATER WELL RECORD Form WWC-5 KSA 82a-1212

1 LOCATION OF WATER WELL: Sedgwick	FRACTION SW 1/4 NE 1/4 SW 1/4	SECTION NUMBER 15	TOWNSHIP NUMBER T 27 S	RANGE NUMBER R 2E E/W
--	---	-----------------------------	----------------------------------	---------------------------------

Distance and direction from nearest town or city street address of well if located within city?
852 N. Bristol Ct. Wichita, Kansas

2 WATER WELL OWNER: BYRNE, Robert	Board of Agriculture, Division of Water Resource
RR#,ST. ADDRESS,BOX #: 852 N. Bristol Ct.	Application Number:
CITY, STATE: Wichita, Kansas	ZIP CODE:

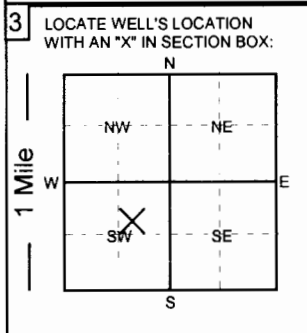

4 DEPTH OF COMPLETED WELL: **97** ft. ELEVATION: _____

Depth of groundwater Encountered: _____ ft.

WELL'S STATIC WATER LEVEL **46** FT. BELOW LAND SURFACE MEASURED ON **12/4/14** mo/day/yr:

Pump test data: Well water was _____ ft. after _____ hours of pumping @ _____ gpm

Est. Yield: _____ gpm Well water was _____ ft. after _____ hours of pumping @ _____ gpm

Bore Hole Diameter **12** in. to **97** ft. and _____ in. to _____ ft.

WELL WATER TO BE USED AS:

1. Domestic	3. Feedlot	5. Public water supply	<u>7. Lawn and garden only</u>	9. Dewatering	11. Injection well
2. Irrigation	4. Industrial	6. Oil field water supply	8. Air conditioning	10. Monitoring well	12. Other (Specify below)

Was a chemical/bacteriological sample submitted to Department? **NO** ; if yes, what mo/day/yr was sample submitted _____

Was Water Well Disinfected? YES **NO**

5 TYPE OF CASING USED:

1. Steel	3. RPM (SR)	5. Wrought Iron	7. Fiberglass	9. Other (Specify below)	CASING JOINTS: <u>Glued</u>	Threaded
<u>2. PVC</u>	4. ABS	6. Asbestos-Cement	8. Concrete tile	SDR-26	Welded	Clamped

Blank casing diameter **5** in. to **50** ft., Dia. in. to _____ ft., Dia. in. to _____ ft.

Casing height above land surface: **12** in., Weight: **2.35** lbs. / ft. Wall thickness or gauge No. **.214**

TYPE OF SCREEN OR PERFORATION MATERIAL:

1. Steel	3. Stainless Steel	5. Fiberglass	<u>7. PVC</u>	9. ABS	11. Other (specify)
2. Brass	4. Galvanized	6. Concrete Tile	8. RMP (SR)	10. Asbestos-Cement	12. None used (open hole)

SCREEN OR PERFORATION OPENINGS ARE:

1. Continuous slot	3. Mill slot	5. Gauzed wrapped	7. Torch cut	9. Drilled holes	11. None (open hole)
2. Louvered shutter	4. Key punched	6. Wire wrapped	<u>8. Saw cut</u>	10. Other (specify)	

SCREEN - PERFORATION INTERVAL

From	50 ft.	to	97 ft.,	From	ft.	to	ft.
From	ft.	to	ft.,	From	ft.	to	ft.

GRAVEL PACK INTERVALS:

From	24 ft.	to	97 ft.,	From	ft.	to	ft.
From	ft.	to	ft.,	From	ft.	to	ft.

6 GROUT MATERIALS: 1. Neat cement 2. Cement Grout 3. Bentonite Other **bentonite hole plug**

Grout Intervals: From **4** ft. to **24** ft., From _____ ft. to _____ ft., From _____ ft. to _____ ft.

What is the nearest source of possible contamination:

1. Septic tank	4. Lateral lines	7. Pit privy	10. Livestock pens	13. Insecticide storage	15. Oil well/Gas well
2. Sewer lines	5. Cess Pool	8. Sewage lagoon	11. Fuel storage	14. Abandon water well	16. Other (specify below)
<u>3. Watertight sewer line</u>	6. Seepage pit	9. Feed yard	12. Fertilizer storage		

Direction from well? East How many feet? **10 ft. plus**

From	To	LITHOLOGIC LOG	From	To	LITHOLOGIC LOG
0	3	topsoil			
3	18	clay			
18	90	gray shale			
90	97	limestone			

7 Contractor's or Landowner's Certification: This water well was 1. constructed 2. reconstructed or 3. plugged under my jurisdiction and was completed on (mo/day/year) **12/4/2014** and this record is true to the best of my knowledge and belief.

Kansas Water Well Contractor's License No. **236** This water well record was completed on (mo/day/year) **12/10/2014**

under the business name of **Harp Well and Pump Service** by (signature) **Todd S. Harp**