


WATER WELL RECORD Form WWC-5 KSA 82a-1212

1 LOCATION OF WATER WELL: Sedgwick FRACTION SE 1/4 SE 1/4 NE 1/4 SECTION NUMBER 11 TOWNSHIP NUMBER T 27 S RANGE NUMBER R 2E E/W

Distance and direction from nearest town or city street address of well if located within city? 1902 N. Split Rail Wichita, Kansas

2 WATER WELL OWNER: ROBL CONSTRUCTION Board of Agriculture, Division of Water Resource RR#.ST. ADDRESS,BOX #: 5842 W. 21st N. CITY, STATE: Wichita, Kansas ZIP CODE: Application Number:

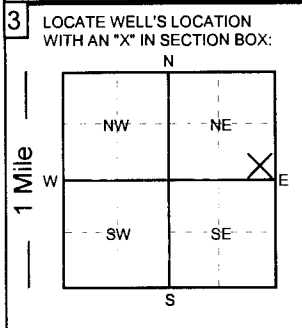

3 LOCATE WELL'S LOCATION WITH AN "X" IN SECTION BOX: 4 DEPTH OF COMPLETED WELL: 85 ft. ELEVATION: WELL'S STATIC WATER LEVEL 48 FT. BELOW LAND SURFACE MEASURED ON 1/27/15

5 TYPE OF CASING USED: 1. Steel 2. PVC 3. RPM (SR) 4. ABS 5. Wrought Iron 6. Asbestos-Cement 7. Fiberglass 8. Concrete tile 9. Other (Specify below) CASING JOINTS: Glued Threaded Welded Clamped

6 GROUT MATERIALS: 1. Neat cement 2. Cement Grout 3. Bentonite Other bentonite hole plug Grout Intervals: From 4 ft. to 24 ft.

LITHOLOGIC LOG table with columns for From, To, and Lithologic Log entries: 0-3 topsoil, 3-9 clay, 9-52 brown shale, 52-85 grey shale.

7 Contractor's or Landowner's Certification: This water well was 1. constructed 2. reconstructed or 3. plugged under my jurisdiction and was completed on (mo/day/year) 1/27/2015

Todd S. Harp (signature)