


WATER WELL RECORD Form WWC-5 KSA 82a-1212

1 LOCATION OF WATER WELL: <b>Sedgwick</b>	FRACTION <b>NW 1/4 SW 1/4 SE 1/4</b>	SECTION NUMBER <b>12</b>	TOWNSHIP NUMBER <b>T 27 S</b>	RANGE NUMBER <b>R 2E E/W</b>
--	---	-----------------------------	----------------------------------	---------------------------------

Distance and direction from nearest town or city street address of well if located within city?  
**1602 N. Graystone Wichita, Kansas**

2 WATER WELL OWNER: <b>NIES CONSTRUCTION</b>	Board of Agriculture, Division of Water Resource
RR#,ST. ADDRESS,BOX #: <b>10333 E. 21st N. #303</b>	Application Number:
CITY, STATE: <b>Wichita, Kansas</b>	ZIP CODE:

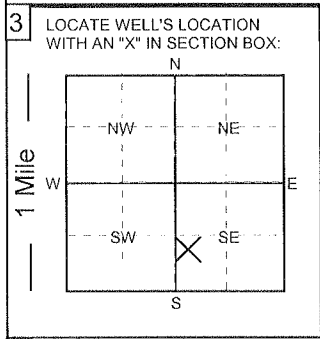

4 DEPTH OF COMPLETED WELL: <b>116</b> ft.	ELEVATION: <b>grade</b>
Depth of groundwater Encountered: _____ ft.	
WELL'S STATIC WATER LEVEL <b>48</b> FT. BELOW LAND SURFACE MEASURED ON <b>mo/day/yr: 2/12/15</b>	
Pump test data: Well water was _____ ft. after _____ hours of pumping @ _____ gpm	
Est. Yield: _____ gpm Well water was _____ ft. after _____ hours of pumping @ _____ gpm	
Bore Hole Diameter <b>12</b> in. to <b>116</b> ft. and _____ in. to _____ ft.	
WELL WATER TO BE USED AS:	
1. Domestic    3. Feedlot    5. Public water supply <b>7. Lawn and garden only</b> 9. Dewatering    11. Injection well 2. Irrigation    4. Industrial    6. Oil field water supply    8. Air conditioning    10. Monitoring well    12. Other (Specify below)	
Was a chemical/bacteriological sample submitted to Department? <b>YES</b> <b>NO</b> ; If yes, what mo/day/yr was sample submitted	
Was Water Well Disinfected? <b>YES</b> <b>NO</b>	

5 TYPE OF CASING USED:		5. Wrought Iron		7. Fiberglass		9. Other (Specify below)		CASING JOINTS: <b>Glued</b>		Threaded	
1. Steel		3. RPM (SR)		8. Concrete tile		SDR-26		Welded		Clamped	
<b>2. PVC</b>		4. ABS		6. Asbestos-Cement							
Blank casing diameter <b>5</b> in. to <b>50</b> ft., Dia. in. to _____ ft., Dia. in. to _____ ft.		Casing height above land surface: <b>12</b> in., Weight: <b>2.35</b> lbs. / ft. Wall thickness or gauge No. <b>.214</b>									
TYPE OF SCREEN OR PERFORATION MATERIAL:		5. Fiberglass		<b>7. PVC</b>		9. ABS		11. Other (specify)			
1. Steel		3. Stainless Steel		8. RMP (SR)		10. Asbestos-Cement		12. None used (open hole)			
2. Brass		4. Galvanized		6. Concrete Tile							
SCREEN OR PERFORATION OPENINGS ARE:		5. Gauzed wrapped		<b>8. Saw cut</b>		9. Drilled holes		11. None ( open hole)			
1. Continuous slot		3. Mill slot		10. Other (specify)							
2. Louvered shutter		4. Key punched		6. Wire wrapped							
SCREEN - PERFORATION INTERVAL		From <b>50</b> ft. to <b>116</b> ft.,		From _____ ft. to _____ ft.,		From _____ ft. to _____ ft.,		From _____ ft. to _____ ft.,			
GRAVEL PACK INTERVALS:		From <b>24</b> ft. to <b>116</b> ft.,		From _____ ft. to _____ ft.,		From _____ ft. to _____ ft.,		From _____ ft. to _____ ft.,			

6 GROUT MATERIALS:		1. Neat cement		2. Cement Grout		3. Bentonite		Other <b>bentonite hole plug</b>	
Grout Intervals: From <b>4</b> ft. to <b>24</b> ft.,		From _____ ft. to _____ ft.,		From _____ ft. to _____ ft.,		From _____ ft. to _____ ft.,		From _____ ft. to _____ ft.,	
What is the nearest source of possible contamination:		7. Pit privy		10. Livestock pens		13. Insecticide storage		15. Oil well/Gas well	
1. Septic tank		4. Lateral lines		11. Fuel storage		14. Abandon water well		16. Other (specify below)	
2. Sewer lines		5. Cess Pool		8. Sewage lagoon		12. Fertilizer storage			
<b>3. Watertight sewer line</b>		6. Seepage pit		9. Feed yard					
Direction from well? <b>South</b>								How many feet? <b>18 ft. plus</b>	

From	To	LITHOLOGIC LOG	From	To	LITHOLOGIC LOG
0	3	topsoil			
3	8	clay			
8	35	brown shale			
35	110	gray shale			
110	116	limestone			

7 Contractor's or Landowner's Certification: This water well was 1. <b>constructed</b> 2. reconstructed or 3. plugged under my jurisdiction and was completed on (mo/day/year) <b>2/12/2015</b> and this record is true to the best of my knowledge and belief.	
Kansas Water Well Contractor's License No. <b>236</b>	This water well record was completed on (mo/day/year) <b>2/13/2015</b>
under the business name of <b>Harp Well and Pump Service</b>	by (signature) <b>Todd S. Harp</b>