

**WATER WELL RECORD Form WWC-5**


Division of Water Resources App. No.

Well ID

Original Record  Correction  Change in Well Use

**1 LOCATION OF WATER WELL:**  
 County: Sedgewick Fraction NE 1/4 NE 1/4 NW 1/4 Section Number 34 Township Number T 27 S Range Number R 2 E W

**2 WELL OWNER:** Last Name: Rain Plus First:   
 Business Address: 1639 S. Lynnae Ct.  
 City: Wichita State: Ks ZIP: 67207  
 Street or Rural Address where well is located (if unknown, distance and direction from nearest town or intersection): If at owner's address, check here:

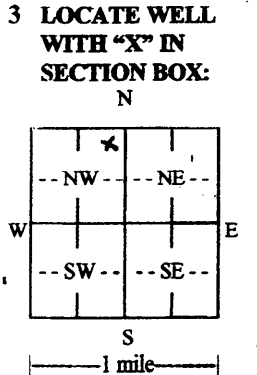

**4 DEPTH OF COMPLETED WELL:** 72 ft.  
 Depth(s) Groundwater Encountered: 1) 51 ft. 2)  ft. 3)  ft. 4)  Dry Well  
 WELL'S STATIC WATER LEVEL: 36 ft. 6/5/15  
 below land surface, measured on (mo-day-yr) 6/5/15  
 above land surface, measured on (mo-day-yr)   
 Pump test data: Well water was  ft. after  hours pumping  gpm  
 Well water was  ft. after  hours pumping  gpm  
 Estimated Yield:  gpm  
 Bore Hole Diameter: 9 in. to 72 ft. and  in. to  ft.

**5 Latitude:**  (decimal degrees)  
**Longitude:**  (decimal degrees)  
 Datum:  WGS 84  NAD 83  NAD 27  
 Source for Latitude/Longitude:  
 GPS (unit make/model: ) (WAAS enabled?  Yes  No)  
 Land Survey  Topographic Map  
 Online Mapper:  
**6 Elevation:**  ft.  Ground Level  TOC  
 Source:  Land Survey  GPS  Topographic Map  
 Other

**7 WELL WATER TO BE USED AS:**

1. Domestic: <input type="checkbox"/> Household <input checked="" type="checkbox"/> Lawn & Garden <input type="checkbox"/> Livestock	2. Irrigation	3. Feedlot	4. Industrial	5. <input type="checkbox"/> Public Water Supply: well ID <u></u>	6. <input type="checkbox"/> Dewatering: how many wells? <u></u>	7. <input type="checkbox"/> Aquifer Recharge: well ID <u></u>	8. <input type="checkbox"/> Monitoring: well ID <u></u>	9. Environmental Remediation: well ID <u></u> <input type="checkbox"/> Air Sparge <input type="checkbox"/> Soil Vapor Extraction <input type="checkbox"/> Recovery <input type="checkbox"/> Injection	10. <input type="checkbox"/> Oil Field Water Supply: lease <u></u>	11. Test Hole: well ID <u></u> <input type="checkbox"/> Cased <input type="checkbox"/> Uncased <input type="checkbox"/> Geotechnical	12. Geothermal: how many bores? <u></u> a) Closed Loop <input type="checkbox"/> Horizontal <input type="checkbox"/> Vertical b) Open Loop <input type="checkbox"/> Surface Discharge <input type="checkbox"/> Inj. of Water	13. <input type="checkbox"/> Other (specify): <u></u>
---	---------------	------------	---------------	--	---	---	---	---	--	---	---	---

Was a chemical/bacteriological sample submitted to KDHE?  Yes  No If yes, date sample was submitted:   
 Water well disinfected?  Yes  No

**8 TYPE OF CASING USED:**  Steel  PVC  Other  CASING JOINTS:  Glued  Clamped  Welded  Threaded  
 Casing diameter 5 in. to  ft. Diameter  in. to  ft. Diameter  in. to  ft.  
 Casing height above land surface 12 in. Weight  lbs./ft. Wall thickness or gauge No. 160 PSI  
**TYPE OF SCREEN OR PERFORATION MATERIAL:**  
 Steel  Stainless Steel  Fiberglass  PVC  Other (Specify)   
 Brass  Galvanized Steel  Concrete tile  None used (open hole)  
**SCREEN OR PERFORATION OPENINGS ARE:**  
 Continuous Slot  Mill Slot  Gauze Wrapped  Torch Cut  Drilled Holes  Other (Specify)   
 Louvered Shutter  Key Punched  Wire Wrapped  Saw Cut  None (Open Hole)  
**SCREEN-PERFORATED INTERVALS:** From 32 ft. to 72 ft., From  ft. to  ft., From  ft. to  ft.  
**GRAVEL PACK INTERVALS:** From 24 ft. to 72 ft., From  ft. to  ft., From  ft. to  ft.

**9 GROUT MATERIAL:**  Neat cement  Cement grout  Bentonite  Other   
 Grout Intervals: From 3 ft. to 24 ft., From  ft. to  ft., From  ft. to  ft.

**Nearest source of possible contamination:**

<input type="checkbox"/> Septic Tank	<input type="checkbox"/> Lateral Lines	<input type="checkbox"/> Pit Privy	<input type="checkbox"/> Livestock Pens	<input type="checkbox"/> Insecticide Storage
<input type="checkbox"/> Sewer Lines	<input type="checkbox"/> Cess Pool	<input type="checkbox"/> Sewage Lagoon	<input type="checkbox"/> Fuel Storage	<input type="checkbox"/> Abandoned Water Well
<input checked="" type="checkbox"/> Watertight Sewer Lines	<input type="checkbox"/> Seepage Pit	<input type="checkbox"/> Feedyard	<input type="checkbox"/> Fertilizer Storage	<input type="checkbox"/> Oil Well/Gas Well
<input type="checkbox"/> Other (Specify) <u></u>				

Direction from well? West Distance from well? 17 ft.

10 FROM	TO	LITHOLOGIC LOG	FROM	TO	LITHO. LOG (cont.) or PLUGGING INTERVALS
0	1	TOP SOIL			
1	9	Clay			
9	45	lime stone			
45	49	gypsum rock			
49	72	shale			

Notes:

**11 CONTRACTOR'S OR LANDOWNER'S CERTIFICATION:** This water well was  constructed,  reconstructed, or  plugged under my jurisdiction and was completed on (mo-day-year) 6-02-15 and this record is true to the best of my knowledge and belief. Kansas Water Well Contractor's License No. 884. This Water Well Record was completed on (mo-day-year) 6-2-15 under the business name of Weninger Drilling