

State

WATER WELL RECORD Form WWC-5

Division of Water Resources App. No.


Well ID

Well ID

Original Record Correction Change in Well Use

1 LOCATION OF WATER WELL: County: Sedgewick Fraction: SE 1/4 SW 1/4 NW 1/4 SW 1/4 Section Number: 24 Township Number: T 27 S Range Number: R 2 E W

2 WELL OWNER: Last Name: Ribble First: Kember Street or Rural Address where well is located (if unknown, distance and direction from nearest town or intersection): If at owner's address, check here: Address: 300 S. Cardinal Ln City: Wichita State: Ks ZIP: 67230

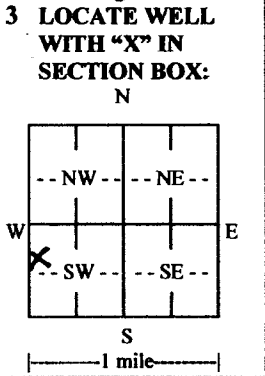

4 DEPTH OF COMPLETED WELL: 100 ft. Depth(s) Groundwater Encountered: 1) 34 ft. 2) ... ft. 3) ... ft., or 4) Dry Well WELL'S STATIC WATER LEVEL: 34 ft. below land surface, measured on (mo-day-yr) above land surface, measured on (mo-day-yr) Pump test data: Well water was ... ft. after ... hours pumping ... gpm Well water was ... ft. after ... hours pumping ... gpm Estimated Yield: 207 gpm Bore Hole Diameter: 1.2 in. to 100 ft. and ... in. to ... ft.

5 Latitude: 37.68306142 (decimal degrees) Longitude: 97.1697346 (decimal degrees) Datum: WGS 84 NAD 83 NAD 27 Source for Latitude/Longitude: GPS (unit make/model) (WAAS enabled? Yes No) Land Survey Topographic Map Online Mapper

6 Elevation: ... ft. Ground Level TOC Source: Land Survey GPS Topographic Map Other

7 WELL WATER TO BE USED AS: 1. Domestic: Household Lawn & Garden Livestock Irrigation Feedlot Industrial 2. Public Water Supply: well ID Dewatering: how many wells? Aquifer Recharge: well ID Monitoring: well ID Environmental Remediation: well ID Air Sparge Soil Vapor Extraction Recovery Injection 10. Oil Field Water Supply: lease 11. Test Hole: well ID Cased Uncased Geotechnical 12. Geothermal: how many bores? a) Closed Loop Horizontal Vertical b) Open Loop Surface Discharge Inj. of Water 13. Other (specify):

Was a chemical/bacteriological sample submitted to KDHE? Yes No If yes, date sample was submitted: Water well disinfected? Yes No

8 TYPE OF CASING USED: Steel PVC Other CASING JOINTS: Glued Clamped Welded Threaded Casing diameter: 5 in. to 100 ft., Diameter in. to ... ft., Diameter in. to ... ft. Casing height above land surface: 12 in. Weight: 160 lbs./ft. Wall thickness or gauge No.: 26

TYPE OF SCREEN OR PERFORATION MATERIAL: Steel Stainless Steel Fiberglass PVC Other (Specify) Brass Galvanized Steel Concrete tile None used (open hole)

SCREEN OR PERFORATION OPENINGS ARE: Continuous Slot Mill Slot Gauze Wrapped Torch Cut Drilled Holes Other (Specify) Louvered Shutter Key Punched Wire Wrapped Saw Cut None (Open Hole)

SCREEN-PERFORATED INTERVALS: From 4.0 ft. to 100 ft., From ... ft. to ... ft., From ... ft. to ... ft. GRAVEL PACK INTERVALS: From 2.4 ft. to 100 ft., From ... ft. to ... ft., From ... ft. to ... ft.

9 GROUT MATERIAL: Neat cement Cement grout Bentonite Other Grout Intervals: From 4 ft. to 24 ft., From ... ft. to ... ft., From ... ft. to ... ft.

Nearest source of possible contamination: Septic Tank Lateral Lines Pit Privy Livestock Pens Insecticide Storage Sewer Lines Cess Pool Sewage Lagoon Fuel Storage Abandoned Water Well Watertight Sewer Lines Seepage Pit Feedyard Fertilizer Storage Oil Well/Gas Well Other (Specify) Direction from well? South Distance from well? 45 ft.

Table with columns: FROM, TO, LITHOLOGIC LOG, FROM, TO, LITHO. LOG (cont.) or PLUGGING INTERVALS. Row 1: 0, 2, Top soil, , , . Row 2: 2, 7, Clay, , , . Row 3: 7, 100, Shale, , , .

Notes:

11 CONTRACTOR'S OR LANDOWNER'S CERTIFICATION: This water well was constructed, reconstructed, or plugged under my jurisdiction and was completed on (mo-day-year) 6-30-15 and this record is true to the best of my knowledge and belief. Kansas Water Well Contractor's License No. 6011 This Water Well Record was completed on (mo-day-year) 7-25-15 under the business name of Chase Drilling