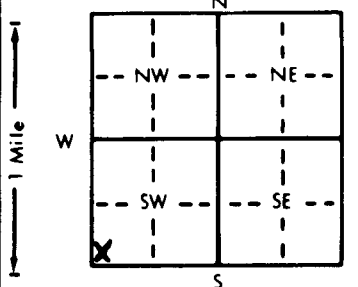


1 LOCATION OF WATER WELL: County: <u>Sedgwick</u>		Fraction <u>SW 1/4 SW 1/4 SW 1/4</u>	Section Number <u>18</u>	Township Number <u>T 27 S</u>	Range Number <u>R 2 E</u>						
Distance and direction from nearest town or city street address of well if located within city? <u>6402 East Central, Wichita, KS</u>											
2 WATER WELL OWNER: <u>Beard Oil Company</u> RR#, St. Address, Box #: <u>14201 Donegl Circle</u> City, State, ZIP Code: <u>Wichita, KS 67230</u>			Board of Agriculture, Division of Water Resources Application Number: <u>MW12</u>								
3 LOCATE WELL'S LOCATION WITH AN "X" IN SECTION BOX: 		4 DEPTH OF COMPLETED WELL: <u>15</u> ft. ELEVATION: <u>Not surveyed yet</u> Depth(s) Groundwater Encountered 1. <u>NA</u> ft. 2. <u>NA</u> ft. 3. <u>NA</u> ft. WELL'S STATIC WATER LEVEL <u>NA</u> ft. below land surface measured on mo/day/yr Pump test data: Well water was <u>NA</u> ft. after <u>NA</u> hours pumping <u>NA</u> gpm Est. Yield <u>NA</u> gpm: Well water was <u>NA</u> ft. after <u>NA</u> hours pumping <u>NA</u> gpm Bore Hole Diameter: <u>8</u> in. to <u>15</u> in. and <u>NA</u> in. to <u>NA</u> in. WELL WATER TO BE USED AS: 1 Domestic 3 Feedlot 6 Oil field water supply 9 Dewatering 12 Other (Specify below) 2 Irrigation 4 Industrial 7 Lawn and garden only 10 Monitoring well Was a chemical/bacteriological sample submitted to Department? Yes <u>No</u> X If yes, mo/day/yr sample was submitted Water Well Disinfected? Yes <u>No</u>									
5 TYPE OF BLANK CASING USED: 1 Steel 3 RMP (SR) 5 Wrought iron 8 Concrete tile CASING JOINTS: Glued <u>Clamped</u> 2 PVC 4 ABS 6 Asbestos-Cement 9 Other (specify below) Welded <u>Threaded</u> Blank casing diameter <u>2 1/2</u> in. <u>NA</u> TYPE OF SCREEN OR PERFORATION MATERIAL: 1 Steel 3 Stainless steel 5 Fiberglass 8 RMP (SR) 10 Asbestos-cement 2 Brass 4 Galvanized steel 6 Concrete tile 9 ABS 11 Other (specify) <u>Threaded</u> 12 None used (open hole) SCREEN OR PERFORATION OPENINGS ARE: 1 Continuous slot 3 Mill slot 5 Gauzed wrapped 8 Saw cut 11 None (open hole) 2 Louvered shutter 4 Key punched 6 Wire wrapped 9 Drilled 
6 GROUT MATERIAL: 1 Neat cement 2 Cement grout 3 Bentonite 4 Other <u>Bentonite</u> Grout intervals: From <u>4</u> ft. to <u>1</u> ft. From <u>1</u> ft. to <u>1</u> ft. From <u>1</u> ft. to <u>1</u> ft. From <u>1</u> ft. to <u>1</u> ft. What is the nearest source of possible contamination: 1 Septic tank 4 Lateral lines 7 Pit privy 10 Livestock pens 14 Abandoned water well 2 Sewer lines 5 Cess pool 8 Sewage lagoon 11 Fuel storage 15 Oil well/Gas well 3 Watertight sewer lines 6 Seepage pit 9 Feedyard 12 Fertilizer storage 16 Other (specify below) Direction from well? <u>Northwest</u> How many feet? <u>100</u>											
FROM		TO		LITHOLOGIC LOG		FROM		TO		PLUGGING INTERVALS	
0		3'		Dark Brown silty clay w/ gray & black mottling, sand traces, iron stains, odor							
3		7'		Brown - gray silty clay w/ gray & black mottling, caliche nodules							
7		12'		Gray sandy clay w/ dark gray & black mottling, iron stains, odor							
12		12'3"		Gray coarse-gr sand & gravel layer, poorly sorted, no odor							
12'3"		13'		Gray sandy clay w/ dark gray & black mottling, iron stains, no odor							
13		15'		Yellow - Gray fractured, weathered shale, no odor, friable, iron veins							
7 CONTRACTOR'S OR LANDOWNER'S CERTIFICATION: This water well was (1) constructed, (2) reconstructed, or (3) plugged under my jurisdiction and was completed on (mo/day/year) <u>Feb. 11th 90</u> and this record is true to the best of my knowledge and belief. Kansas Water Well Contractor's License No. <u>634</u> This Water Well Record was completed on (mo/day/yr) <u>March 6 90</u> under the business name of <u>Shirley Environmental Testing LLC</u> by (signature) <u>Murphy</u>											
INSTRUCTIONS: Use typewriter or ball point pen. PLEASE PRESS FIRMLY and PRINT clearly. Please fill in blanks, underline or circle the correct answers. Send top three copies to Kansas Department of Health and Environment, Bureau of Water, Topeka, Kansas 66620-0001. Telephone: 913-296-5545. Send one to WATER WELL OWNER and retain one for your records.											

RECEIVED

APR 01 1990

BUREAU OF WATER