WATER WELL RECORD Form WWC-5 KSA 82a-1212

1 LOCATION OF WATER WELL: County: Sedgwick | Fraction: SW ¼ SW ¼ SW ¼ | Section Number: 18 | Township Number: T 27 S | Range Number: R 2 (E)W

Distance and direction from nearest town or city street address of well if located within city? 6402 East Central

2 WATER WELL OWNER: Brandon Co.
RR#, St. Address, Box # : 6402 E. Central Ave
City, State, ZIP Code : Wichita, KS 67206 MW25

Board of Agriculture, Division of Water Resources
Application Number:

3 LOCATE WELL'S LOCATION WITH AN "X" IN SECTION BOX:

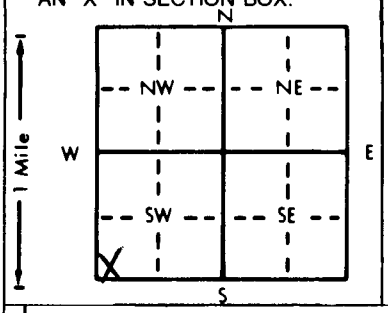

4 DEPTH OF COMPLETED WELL 15 ft. ELEVATION: Not Surveyed yet

Depth(s) Groundwater Encountered 1. NA ft. 2. — ft. 3. — ft.

WELL'S STATIC WATER LEVEL NA ft. below land surface measured on mo/day/yr —

Pump test data: Well water was — ft. after — hours pumping — gpm

Est. Yield — gpm: Well water was — ft. after — hours pumping — gpm

Bore Hole Diameter 8 in. to 15 ft., and — in. to — ft.

WELL WATER TO BE USED AS: 5 Public water supply 8 Air conditioning 11 Injection well
1 Domestic 3 Feedlot 6 Oil field water supply 9 Dewatering 12 Other (Specify below)
2 Irrigation 4 Industrial 7 Lawn and garden only (10) Monitoring well

Was a chemical/bacteriological sample submitted to Department? Yes ..... No X ; If yes, mo/day/yr sample was submitted

Water Well Disinfected? Yes (No)

5 TYPE OF BLANK CASING USED: 5 Wrought iron 8 Concrete tile CASING JOINTS: Glued ..... Clamped .....
1 Steel 3 RMP (SR) 6 Asbestos-Cement 9 Other (specify below) Welded .....
(2) PVC 4 ABS 7 Fiberglass Threaded ✓

Blank casing diameter 2" in. to 3 ft., Dia ..... in. to ..... ft., Dia ..... in. to ..... ft.

Casing height above land surface Flush in., weight ..... lbs./ft. Wall thickness or gauge No. .....

TYPE OF SCREEN OR PERFORATION MATERIAL: (7) PVC 10 Asbestos-cement
1 Steel 3 Stainless steel 5 Fiberglass 8 RMP (SR) 11 Other (specify) .....
2 Brass 4 Galvanized steel 6 Concrete tile 9 ABS 12 None used (open hole)

SCREEN OR PERFORATION OPENINGS ARE: 5 Gauzed wrapped 8 Saw cut 11 None (open hole)
1 Continuous slot (3) Mill slot 6 Wire wrapped 9 Drilled holes
2 Louvered shutter 4 Key punched 7 Torch cut 10 Other (specify) .....

SCREEN-PERFORATED INTERVALS: From 15' ft. to 8+3 ft., From — ft. to — ft.
From — ft. to — ft., From — ft. to — ft.

GRAVEL PACK INTERVALS: From 15' ft. to 4+2 ft., From — ft. to — ft.
From — ft. to — ft., From — ft. to — ft.

6 GROUT MATERIAL: (1) Neat cement 2 Cement grout (3) Bentonite 4 Other .....

Grout Intervals: From 4" ft. to 15' ft., From — ft. to — ft., From — ft. to — ft.

What is the nearest source of possible contamination:
10 Livestock pens 14 Abandoned water well
1 Septic tank 4 Lateral lines 7 Pit privy (11) Fuel storage 15 Oil well/Gas well
2 Sewer lines 5 Cess pool 8 Sewage lagoon 12 Fertilizer storage 16 Other (specify below)
3 Watertight sewer lines 6 Seepage pit 9 Feedyard 13 Insecticide storage .....

Direction from well? Southeast How many feet? 150

FROM	TO	LITHOLOGIC LOG	FROM	TO	PLUGGING INTERVALS
4"	6'	Brown silty clay, firm, odor			
6	7'	Gray silty clay, odor, firm, sand traces			
7	15'	Gray sandy clay, wet, soft, odor			

7 CONTRACTOR'S OR LANDOWNER'S CERTIFICATION: This water well was (1) constructed, (2) reconstructed, or (3) plugged under my jurisdiction and was completed on (mo/day/year) 4-24-90 and this record is true to the best of my knowledge and belief. Kansas Water Well Contractor's License No. 634 This Water Well Record was completed on (mo/day/yr) 6-8-90 under the business name of Shirley Eng. Testing by (signature) [signature]

INSTRUCTIONS: Use typewriter or ball point pen. *PLEASE PRESS FIRMLY* and *PRINT* clearly. Please fill in blanks, underline or circle the correct answers. Send top three copies to Kansas Department of Health and Environment, Bureau of Water, Topeka, Kansas 66620-0001. Telephone: 913-296-5545. Send one to WATER WELL OWNER and retain one for your records.

OFFICE USE ONLY T R E/W SEC. ¼ ¼ ¼