


1 LOCATION OF WATER WELL: County: <u>Sedgwick</u>	Fraction <u>NW SW SE NE</u> <u>SE</u> 1/4 <u>1/4</u> <u>1/4</u> <u>1/4</u>	Section Number <u>24</u>	Township Number T <u>27</u> S	Range Number R <u>2</u> EW
--	---	-----------------------------	----------------------------------	-------------------------------

Distance and direction from nearest town or city street address of well if located within city?

144 Chelmsford Ct. Sedgwick Co. Wichita, Ks 67230

2 WATER WELL OWNER: <u>BIJAN MOUSSAYI</u> RR#, St. Address, Box # : <u>144 Chelmsford Ct.</u> City, State, ZIP Code : <u>Wichita, Ks 67230</u>	Board of Agriculture, Division of Water Resources Application Number: <u>NA</u>
--	--

3 LOCATE WELL'S LOCATION WITH AN "X" IN SECTION BOX:	4 DEPTH OF COMPLETED WELL: <u>100</u> ft. ELEVATION: <u>NA</u>
--	--

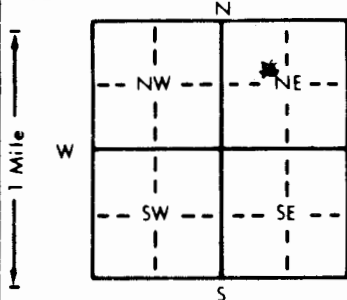

Depth(s) Groundwater Encountered 1. 89 ft. 2. NA ft. 3. NA ft.
WELL'S STATIC WATER LEVEL 28 ft. below land surface measured on mo/day/yr 10-6-97

Pump test data: Well water was 35 ft. after 5 hours pumping 25 gpm
Est. Yield 50 gpm: Well water was NA ft. after NA hours pumping NA gpm

Bore Hole Diameter 10 in. to 100 ft., and NA in. to NA ft.

WELL WATER TO BE USED AS:
1 Domestic 3 Feedlot 6 Oil field water supply 8 Air conditioning 11 Injection well
2 Irrigation 4 Industrial 7 Lawn and garden only 9 Dewatering 12 Other (Specify below)

Was a chemical/bacteriological sample submitted to Department? Yes NA No X; If yes, mo/day/yr sample was submitted NA Water Well Disinfected? Yes X No

5 TYPE OF BLANK CASING USED: 1 Steel <u>2</u> PVC 3 RMP (SR) 4 ABS	5 Wrought iron 6 Asbestos-Cement 7 Fiberglass	8 Concrete tile 9 Other (specify below)	CASING JOINTS: Glued <u>NA</u> Clamped <u>NA</u> Welded <u>NA</u> Threaded <u>NA</u>
--	---	--	--

Blank casing diameter 5 in. to 80 ft., Dia NA in. to NA ft., Dia NA in. to NA ft.
Casing height above land surface 18 in., weight 3.364 SDR-26 lbs./ft. Wall thickness or gauge No. 255

TYPE OF SCREEN OR PERFORATION MATERIAL: 1 Steel 2 Brass 3 Stainless steel 4 Galvanized steel 5 Fiberglass 6 Concrete tile	<u>7</u> PVC 8 RMP (SR) 9 ABS 10 Asbestos-cement 11 Other (specify) 12 None used (open hole)
---	---

SCREEN OR PERFORATION OPENINGS ARE: 1 Continuous slot 2 Louvered shutter 3 Mill slot 4 Key punched	5 Gauzed wrapped 6 Wire wrapped 7 Torch cut 8 Saw cut 9 Drilled holes 10 Other (specify) 11 None (open hole)
--	--

SCREEN-PERFORATED INTERVALS: From <u>80</u> ft. to <u>100</u> ft., From <u>NA</u> ft. to <u>NA</u> ft., From <u>NA</u> ft. to <u>NA</u> ft.	GRAVEL PACK INTERVALS: From <u>22</u> ft. to <u>100</u> ft., From <u>NA</u> ft. to <u>NA</u> ft., From <u>NA</u> ft. to <u>NA</u> ft.
---	---

6 GROUT MATERIAL: <u>1</u> Neat cement 2 Cement grout 3 Bentonite 4 Other	Grout Intervals: From <u>2</u> ft. to <u>22</u> ft., From <u>NA</u> ft. to <u>NA</u> ft., From <u>NA</u> ft. to <u>NA</u> ft.
--	---

What is the nearest source of possible contamination: 1 Septic tank <u>2</u> Sewer lines 3 Watertight sewer lines 4 Lateral lines 5 Cess pool 6 Seepage pit 7 Pit privy 8 Sewage lagoon 9 Feedyard	10 Livestock pens 11 Fuel storage 12 Fertilizer storage 13 Insecticide storage 14 Abandoned water well 15 Oil well/Gas well 16 Other (specify below)
---	--

Direction from well? N How many feet? 75

FROM	TO	LITHOLOGIC LOG	FROM	TO	PLUGGING INTERVALS
0	3	TOP SOIL			
3	12	SANDY CLAY			
12	28	GREEN SHALE			
28	40	GRAY SHALE			
40	41	LIME			
41	63	GRAY SHALE			
63	68	CHALK/SHALE			
68	89	GRAY SHALE			
89	98	SAND/GRAY SHALE			
100		LIME			

7 CONTRACTOR'S OR LANDOWNER'S CERTIFICATION: This water well was <u>1</u> constructed, (2) reconstructed, or (3) plugged under my jurisdiction and was completed on (mo/day/year) <u>10-6-97</u> and this record is true to the best of my knowledge and belief. Kansas Water Well Contractor's License No. <u>464</u> This Water Well Record was completed on (mo/day/year) <u>11-14-97</u> under the business name of <u>WATER WELL SERVICES</u> by (signature) <u>Robert L. Shady</u>
--