WATER WELL RECORD Form WWC-5 KSA 82a-1212

1 LOCATION OF WATER WELL: County: Sedgwick	Fraction: SW ¼ SW ¼ SW ¼	Section Number: 29	Township Number: T 27 S	Range Number: R 2 E/W

Distance and direction from nearest town or city street address of well if located within city? 1250 S. Rock Rd. Wichita Ks.

2 WATER WELL OWNER: Phillips 66 Co. station #26635
RR#, St. Address, Box # : 1250 S. Rock Rd.
City, State, ZIP Code : Wichita, Ks. 74005

Board of Agriculture, Division of Water Resources Application Number:

3 LOCATE WELL'S LOCATION WITH AN "X" IN SECTION BOX:

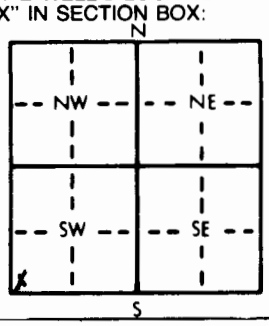

4 DEPTH OF COMPLETED WELL 25 ft. ELEVATION: 1333.03

Depth(s) Groundwater Encountered 1. 15.63 ft. 2. ft. 3. ft.

WELL'S STATIC WATER LEVEL 15.66 ft. below land surface measured on mo/day/yr

Pump test data: Well water was N.A. ft. after hours pumping gpm

Est. Yield N.A gpm: Well water was ft. after hours pumping gpm

Bore Hole Diameter 8 in. to 25 ft., and in. to ft.

WELL WATER TO BE USED AS: 5 Public water supply 8 Air conditioning 11 Injection well; 1 Domestic 3 Feedlot 6 Oil field water supply 9 Dewatering 12 Other (Specify below); 2 Irrigation 4 Industrial 7 Lawn and garden only (10 Monitoring well)

Was a chemical/bacteriological sample submitted to Department? Yes X No ; If yes, mo/day/yr sample was submitted N.A. Water Well Disinfected? Yes No X

5 TYPE OF BLANK CASING USED: 5 Wrought iron 8 Concrete tile CASING JOINTS: Glued Clamped; 1 Steel 3 RMP (SR) 6 Asbestos-Cement 9 Other (specify below) Welded; (2 PVC) 4 ABS 7 Fiberglass Threaded X

Blank casing diameter 2 in. to 1.5 ft., Dia in. to ft., Dia in. to ft.

Casing height above land surface 0 in., weight lbs./ft. Wall thickness or gauge No. Sch. 40

TYPE OF SCREEN OR PERFORATION MATERIAL: (7 PVC) 10 Asbestos-cement; 1 Steel 3 Stainless steel 5 Fiberglass 8 RMP (SR) 11 Other (specify); 2 Brass 4 Galvanized steel 6 Concrete tile 9 ABS 12 None used (open hole)

SCREEN OR PERFORATION OPENINGS ARE: 5 Gauzed wrapped (8 Saw cut) 11 None (open hole); 1 Continuous slot 3 Mill slot 6 Wire wrapped 9 Drilled holes; 2 Louvered shutter 4 Key punched 7 Torch cut 10 Other (specify)

SCREEN-PERFORATED INTERVALS: From 25 ft. to 15 ft., From ft. to ft.; From ft. to ft., From ft. to ft.

GRAVEL PACK INTERVALS: From 25 ft. to 8 ft., From ft. to ft.; From ft. to ft., From ft. to ft.

6 GROUT MATERIAL: 1 Neat cement 2 Cement grout (3 Bentonite) 4 Other 2-0-Cement F.M.

Grout Intervals: From 8 ft. to 2 ft., From ft. to ft., From ft. to ft.

What is the nearest source of possible contamination: 10 Livestock pens 14 Abandoned water well; 1 Septic tank 4 Lateral lines 7 Pit privy 11 Fuel storage 15 Oil well/Gas well; 2 Sewer lines 5 Cess pool 8 Sewage lagoon 12 Fertilizer storage 16 Other (specify below); 3 Watertight sewer lines 6 Seepage pit 9 Feedyard 13 Insecticide storage N.A.

Direction from well? How many feet?

FROM	TO	LITHOLOGIC LOG	FROM	TO	PLUGGING INTERVALS
2	6	Silty Reddish Brown Clay			
6	7.5	Silty Clay Olive-Trace Sand			
7.5	18	Olive + dark Clay			
18	25	Clay + Sand Lenses			

7 CONTRACTOR'S OR LANDOWNER'S CERTIFICATION: This water well was (1) (constructed) (2) reconstructed, or (3) plugged under my jurisdiction and was completed on (mo/day/year) 6-12-98 and this record is true to the best of my knowledge and belief. Kansas Water Well Contractor's License No. 554 This Water Well Record was completed on (mo/day/yr) 7-9-98 under the business name of Woofter Pump + Well Inc. by (signature) Gary C. Woofter

INSTRUCTIONS: Use typewriter or ball point pen. *PLEASE PRESS FIRMLY* and *PRINT* clearly. Please fill in blanks, underline or circle the correct answers. Send top three copies to Kansas Department of Health and Environment, Bureau of Water, Topeka, Kansas 66620-0001. Telephone: 913-296-5545. Send one to WATER WELL OWNER and retain one for your records.

OFFICE USE ONLY T R E/W SEC. ¼ ¼ ¼