

WATER WELL RECORD Form WWC-5


Division of Water Resources App. No.

Original Record Correction Change in Well Use

Well ID

1 LOCATION OF WATER WELL: County: Sedgwick Fraction SE 1/4 SE 1/4 NE 1/4 SW 1/4 Section Number 26 Township Number T 27 S Range Number R 2 E W

2 WELL OWNER: Last Name: Business: Rain Plus Address: 3721 E. Kelloqg Drive City: Wichita State: KS ZIP: 67218 Street or Rural Address where well is located: 1328 S. Gateway Wichita, KS

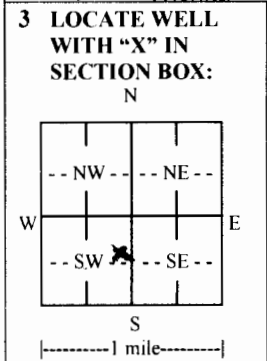

3 LOCATE WELL WITH 'X' IN SECTION BOX: 4 DEPTH OF COMPLETED WELL: 67 ft. Depth(s) Groundwater Encountered: 1) 38 ft. 2) ... 3) ... 4) Dry Well WELL'S STATIC WATER LEVEL: 34 ft. below land surface, measured on (mo-day-yr) 2/27/16

5 Latitude: ... Longitude: ... Horizontal Datum: WGS 84 NAD 83 NAD 27 Source for Latitude/Longitude: GPS Land Survey Topographic Map Online Mapper 6 Elevation: ... Source: Land Survey GPS Topographic Map Other

7 WELL WATER TO BE USED AS: 1. Domestic: Household Lawn & Garden Livestock Irrigation Feedlot Industrial 5. Public Water Supply: well ID 6. Dewatering: how many wells? 7. Aquifer Recharge: well ID 8. Monitoring: well ID 9. Environmental Remediation: well ID Air Sparge Soil Vapor Extraction Recovery Injection 10. Oil Field Water Supply: lease 11. Test Hole: well ID Cased Uncased Geotechnical 12. Geothermal: how many bores? a) Closed Loop Horizontal Vertical b) Open Loop Surface Discharge Inj. of Water 13. Other (specify):

Was a chemical/bacteriological sample submitted to KDHE? Yes No If yes, date sample was submitted: Water well disinfected? Yes No

8 TYPE OF CASING USED: Steel PVC Other CASING JOINTS: Glued Clamped Welded Threaded Casing diameter 5 in. to 67 ft. Diameter in. to ft. Diameter in. to ft. Casing height above land surface 12 in. Weight lbs./ft. Wall thickness or gauge No. sdr-26 TYPE OF SCREEN OR PERFORATION MATERIAL: Steel Stainless Steel Fiberglass PVC Brass Galvanized Steel Concrete tile None used (open hole) SCREEN OR PERFORATION OPENINGS ARE: Continuous Slot Mill Slot Gauze Wrapped Torch Cut Drilled Holes Other (Specify) Louvered Shutter Key Punched Wire Wrapped Saw Cut None (Open Hole) SCREEN-PERFORATED INTERVALS: From 47 ft. to 67 ft. From ft. to ft. From ft. to ft. GRAVEL PACK INTERVALS: From 26 ft. to 67 ft. From ft. to ft. From ft. to ft.

9 GROUT MATERIAL: Neat cement Cement grout Bentonite Other Grout Intervals: From 3 ft. to 26 ft. From ft. to ft. From ft. to ft. Nearest source of possible contamination: Septic Tank Lateral Lines Pit Privy Livestock Pens Insecticide Storage Sewer Lines Cess Pool Sewage Lagoon Fuel Storage Abandoned Water Well Watertight Sewer Lines Seepage Pit Feedyard Fertilizer Storage Oil Well/Gas Well Other (Specify) Direction from well? East Distance from well? 19 ft.

Table with columns: 10 FROM, TO, LITHOLOGIC LOG, FROM, TO, LITHO. LOG (cont.) or PLUGGING INTERVALS. Rows: 0-1 Top Soil, 1-14 Clay, 14-28 Limestone, 28-55 Soft Shale, 55-67 Shale.

11 CONTRACTOR'S OR LANDOWNER'S CERTIFICATION: This water well was constructed, reconstructed, or plugged under my jurisdiction and was completed on (mo-day-year) 2/27/16 and this record is true to the best of my knowledge and belief. Kansas Water Well Contractor's License No. 884 This Water Well Record was completed on (mo-day-year) 4/1/16 under the business name of Weninger Drilling LLC Signature