


WATER WELL RECORD Form WWC-5 KSA 82a-1212

1 LOCATION OF WATER WELL: Sedgwick	FRACTION SW 1/4 SE 1/4 NE 1/4	SECTION NUMBER 36	TOWNSHIP NUMBER T 27 S	RANGE NUMBER R 2E EW
--	---	-----------------------------	----------------------------------	--------------------------------

Distance and direction from nearest town or city street address of well if located within city?
15603 E. Hazelwood Circle Wichita, Kansas

2 WATER WELL OWNER: JERKIE, Gary Construction	Board of Agriculture, Division of Water Resource
RR#,ST. ADDRESS,BOX #: 7309 E. 32nd Ct. N.	Application Number:
CITY, STATE: Wichita, Kansas	ZIP CODE: 67226

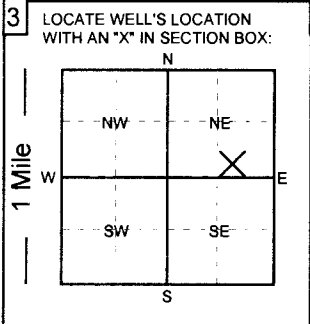

4 DEPTH OF COMPLETED WELL: 80 ft.	ELEVATION:	ft.	ft.
Depth of groundwater Encountered: _____ ft.			
WELL'S STATIC WATER LEVEL 25 FT. BELOW LAND SURFACE MEASURED ON mo/day/yr: 1/9/17			
Pump test data: Well water was _____ ft. after _____ hours of pumping @ _____ gpm			
Est. Yield: _____ gpm Well water was _____ ft. after _____ hours of pumping @ _____ gpm			
Bore Hole Diameter 12 in. to 80 ft. and _____ in. to _____ ft.			
WELL WATER TO BE USED AS:			
1. Domestic 3. Feedlot 5. Public water supply <u>7. Lawn and garden only</u> 9. Dewatering 11. Injection well			
2. Irrigation 4. Industrial 6. Oil field water supply 8. Air conditioning 10. Monitoring well 12. Other (Specify below)			
Was a chemical/bacteriological sample submitted to Department? YES <u>NO</u> ; If yes, what mo/day/yr was sample submitted			
Was Water Well Disinfected? <u>YES</u> NO			

5 TYPE OF CASING USED:	5. Wrought Iron	7. Fiberglass	9. Other (Specify below)
1. Steel	3. RPM (SR)	6. Asbestos-Cement	8. Concrete tile
<u>2. PVC</u>	4. ABS	SDR-26	
Blank casing diameter 5 in. to 30 ft., Dia. _____ in. to _____ ft., Dia. _____ in. to _____ ft.	CASING JOINTS: <u>Glued</u> Threaded		
Casing height above land surface: 12 in., Weight: 2.35 lbs. / ft. Wall thickness or gauge No. .214	Welded Clamped		
TYPE OF SCREEN OR PERFORATION MATERIAL:			
1. Steel	3. Stainless Steel	5. Fiberglass	<u>7. PVC</u>
2. Brass	4. Galvanized	6. Concrete Tile	8. RMP (SR)
SCREEN OR PERFORATION OPENINGS ARE:		9. ABS	11. Other (specify)
1. Continuous slot	3. Mill slot	5. Gauzed wrapped	7. Torch cut
2. Louvered shutter	4. Key punched	6. Wire wrapped	<u>8. Saw cut</u>
9. Drilled holes	11. None (open hole)	10. Other (specify)	
SCREEN - PERFORATION INTERVAL From 30 ft. to 80 ft., From _____ ft. to _____ ft.			
GRAVEL PACK INTERVALS: From 24 ft. to 80 ft., From _____ ft. to _____ ft.			

6 GROUT MATERIALS:	1. Neat cement	2. Cement Grout	3. Bentonite
Other bentonite hole plug			
Grout Intervals: From 4 ft. to 24 ft., From _____ ft. to _____ ft., From _____ ft. to _____ ft.			
What is the nearest source of possible contamination:			
1. Septic tank	4. Lateral lines	7. Pit privy	10. Livestock pens
2. Sewer lines	5. Cess Pool	8. Sewage lagoon	11. Fuel storage
<u>3. Watertight sewer line</u>	6. Seepage pit	9. Feed yard	12. Fertilizer storage
Direction from well? East			How many feet? 10 ft. plus

From	To	LITHOLOGIC LOG	From	To	LITHOLOGIC LOG
0	3	topsoil			
3	12	clay			
12	62	brown shale			
62	80	grey shale			

7 Contractor's or Landowner's Certification: This water well was 1. <u>constructed</u> 2. reconstructed or 3. plugged under my jurisdiction and was completed on (mo/day/year) 1/9/17 and this record is true to the best of my knowledge and belief.			
Kansas Water Well Contractor's License No. 236		This water well record was completed on (mo/day/year) 1/13/17	
under the business name of Harp Well and Pump Service		by (signature) Todd S. Harp	