

WATER WELL RECORD

Form WWC-5

Division of Water Resources App. No.


Well ID

MW8

Original Record Correction Change in Well Ust

1 LOCATION OF WATER WELL: County Sedgwick Fraction SE 1/4 SE 1/4 SE 1/4 SE 1/4 Section Number 17 Township Number T 27 S R 2 E W Range Number

2 WELL OWNER: Last Name: Faber Trust Properties, LLC Business Address: 11500 W. 29th St., North City Wichita State: KS ZIP: 67205 Street or Rural Address where well is located: ~140' SW of 550 N Webb Rd., Wichita KS

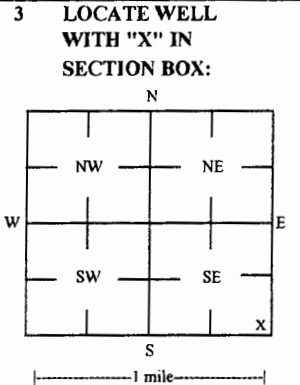

3 LOCATE WELL WITH 'X' IN SECTION BOX: 4 DEPTH OF COMPLETED WELL: 24.89 ft Depth(s) Groundwater Encountered: 1) 17.45 ft 2) 3) 4) Dry Well WELL'S STATIC WATER LEVEL: 17.45 ft

5 Latitude: 37.69452 (decimal degrees) Longitude: 97.22652 (decimal degrees) Horizontal Datum: WGS 84 X NAD 83 NAD 27 Source for Latitude/Longitude: GPS (unit make/model): (WAAS enabled? Yes No) X Land Survey Topographic Map Online Mapper

6 Elevation 1185.65 ft Ground Level X TOC Source X Land Survey GPS Topographic Map Other

7 WELL WATER TO BE USED AS: 1 Domestic: Household Lawn & Garden Livestock Irrigation Feedlot Industrial 2 Public Water Supply: well ID 3 Dewatering: how many wells? 4 Aquifer Recharge: well ID 5 Monitoring: well ID MW8 6 Environmental Remediation: well ID 7 Air Sparge Soil Vapor Extractor Recovery Injection 8 Oil Field Water Supply: lease 9 Test Hole: well ID 10 Cased Uncased Geotechnical 11 Geothermal: How many bores? 12 a) Closed Loop Horizontal Vertical b) Open Loop Surface Discharge Inj. of Water Other (specify):

Was a chemical/bacteriological sample submitted to KDHE? Yes X No If yes, date sample was submitted: Water well disinfected? Yes X No

8 TYPE OF CASING USED: Steel X PVC Other CASING JOINTS: Glued Clamped Welded X Threaded Casing diameter 2 in. to 9.89 ft, Diameter in. to ft, Diameter in. to ft, Casing height above land surface -0.58 in. Weight lbs./ft. Well thickness or gauge No TYPE OF SCREEN OR PERFORATION MATERIAL: Steel Stainless Steel Fiberglass X PVC Other (Specify) Brass Galvanized Steel Concrete tile None used (open hole) SCREEN OR PERFORATION OPENINGS ARE: Continuous Slot X Mill Slot Gauze Wrapped Torch Cut Drilled Holes Other (Specify) Louvered Shutter Key Punched Wire Wrapped Saw Cut None (Open Hole) SCREEN-PERFORATED INTERVALS: From 9.89 ft. to 24.89 ft, From ft. to ft, From ft. to ft, GRAVEL PACK INTERVALS: From 8.5 ft. to 25.5 ft, From ft. to ft, From ft. to ft,

9 GROUT MATERIAL: Neat cement Cement grout X Bentonite X Other Concrete: 0-0.5' Grout intervals: From 0.5 ft. to 8.5 ft, From ft. to ft, From ft. to ft,

Nearest source of possible contamination: Septic Tank Lateral Lines Pit Privy Livestock Pens Insecticide Storage Sewer Lines Cess Pool Sewage Lagoon X Fuel Storage Abandoned Water Well Watertight Sewer Lines Seepage Pit Feedyard Fertilizer Storage Oil Well / Gas Well Other (Specify) Direction from well? NE Distance from well? ~220 ft

Table with columns: FROM, TO, LITHOLOGIC LOG, FROM, TO, LITHO. LOG (cont.) or PLUGGING INTERVALS. Rows: 0 to 0.3 (Topsoil), 0.3 to 13 (Silty clay), 13 to 25.5 (Claystone/Shale)

Notes: KDHE ID: Fuel Up; U2-087-13695

11 CONTRACTOR'S OR LANDOWNER'S CERTIFICATION: This water well was X constructed, reconstructed, or plugged under my jurisdiction and was completed on (mo-day-year) 10/4/16 and this record is true to the best of my knowledge and belief. Kansas Water Well Contractor's License No 757 This Water Well Record was completed on (mo-day-year) 11/15/16 under the business name of Larsen & Associates, Inc. Signature

Mail 1 white copy along with a fee of \$5.00 for each constructed well to: Kansas Department of Health and Environment, Bureau of Water, GWIS Section, 1000 SW Jackson St., Suite 420, Topeka, Kansas 66612-1367. Mail one to Water Well Owner and retain one for your records. Telephone 785-296-5524.

SMH CONSULTANTS

October 25, 2016

Larsen & Associates, Inc.
Jessica Chapman
1311 East 25th Street, Suite B
Lawrence, Kansas 66046
Email: Jess@larsenenvironmental.com

RE: Project No. 1610MN1217

Jess:

The following is the information requested on a Monitoring Well Site, Fuel Up, 550 North Webb Road, Wichita, Sedgwick County, Kansas.

Point	North Coord.	East Coord.	Distance SE Cor. North	From S.16 West	Elev. Top Of Rim or PK Nail	Elev. Top of PVC Pipe	Latitude North	Longitude West
SE Corner S.16-T27S-R02E	10000	10000						
MW8	10149.19	4643.45	149.19	5356.55	1186.23	1185.65	37.69452	97.22652
Site BM	10258.62	4789.66	258.62	5210.34		BM Elevation = 1186.53		

BM Description: "X" cut on top of curb at the southwest corner of the parking lot on site.

MW8 is in the: SE¼ SE¼ SE¼ SE¼ S.17-T27S-R02E

If you have any questions, please do not hesitate in giving us a call.

Sincerely,



Tim Sloan, L.S.
SMH CONSULTANTS

RECEIVED
FEB 02 2017
BUREAU OF WATER