
WATER WELL PLUGGING RECOR	D Form WW	C-5P	KSA 92	a-1212	ID NO.	SAL 3	6 I
1 LOCATION OF WATER WELL: Fraction		Section N	Number	Township	Number	Range Num	ber
County: Sedgewick 1/4 S Street/Rural Address of Well Location; if unknown	W 145W 145W 1			T 27 Systems (CI			]E   W
direction from nearest town or intersection: If at o	Global Positioning Systems (GPS) information:  Latitude: 37.68015 (in decimal degrees)						
check here Northeast corner of S 127th Street E and 54		Longitude: -97.18915 (in decimal degrees)					
Highway; Wichita, KS		Horizontal Datum: WGS84, NAD83, NAD27					
		Collection Method:  GPS unit (Make/Model: Garmin etrek					
2 WATER WELL OWNER: Raytheon Aircraft Co. RR#, St. Address, Box #: 9709 E Central		Digital Map/Photo, Topographic Map, Land Survey					
City, State ZIP Code: Wichita, KS 67206		Est. Accuracy: □ < 3 m,  3-5 m, □ 5-15 m, □ > 15 m					
							- 13 111
WITH AN "X" IN SECTION							
l N	TER LEVEL ft						
WELL WAS USED AS:							
NW NE Domestic Public Water Supply Dewatering SAL 36I							361
W   Feedlot   Oil Field Water Supply   Monitoring   Injection Well							
sw SE Industrial Air Conditioning Other							
Was a chemical/bacteriological sample submitted to Department? Yes No							
5 TYPE OF BLANK CASING USED:							
Steel RMP (SR) Wrought Fiberglass Other (Specify below)  ABS Concrete Tile							
Blank casing diameter 2 in. Was casing pulled? Yes No If yes, how much all							
Casing height above or below land surface _6 in.							
6 GROUT PLUG MATERIAL: Neat cement Cement grout Bentonite Other Top Soil							
Grout Plug Intervals: From 0 ft. to 3 ft., From 3 ft. to 63 ft., From ft. to ft.							
What is the nearest source of possible contamination:							
Septic tank Sewer lines  Seepage pit Pit privy  Fuel storage Fertilizer storage  Other (specify below)							
Watertight sewer lines   Sewage lagoon   Insecticide storage							
Lateral lines Feedyard Abandoned water well Direction from well?  Cess pool Livestock pens Oil well/Gas well How many feet?							
FROM TO PLUGGING M.  Top Soil	IATERIALS	FROM	TO	PL	UGGING	MATERIAL	S
3 63 Bentonite							
7 CONTRACTOR'S OR LANDOWNER'S CERTIFICATION: This water well was plugged under my jurisdiction and was							
completed on (mo/day/year) 10/06/2016 and this record is true to the best of my knowledge and belief. Kansas Water							
Well Contractor's License No. 710 . This Water Well Record was completed on mo/day/year) 1/20/2017 under the business name of Below Ground Surface, Inc. by (signature)							
Send one white copy to Kansas Department of Health & Environment, Geology Section, 1000 SW Jackson Street, Ste. 420, Topeka, KS							
66612-1367. Send one copy to WATER WELL OWNER and retain one for your records.							
Visit us at <a href="http://www.kdheks.gov/waterwell/index.html">http://www.kdheks.gov/waterwell/index.html</a> Telephone 785-296-5524.							
KSA8						Revised 1/	20/2015

## **Drilling Log**

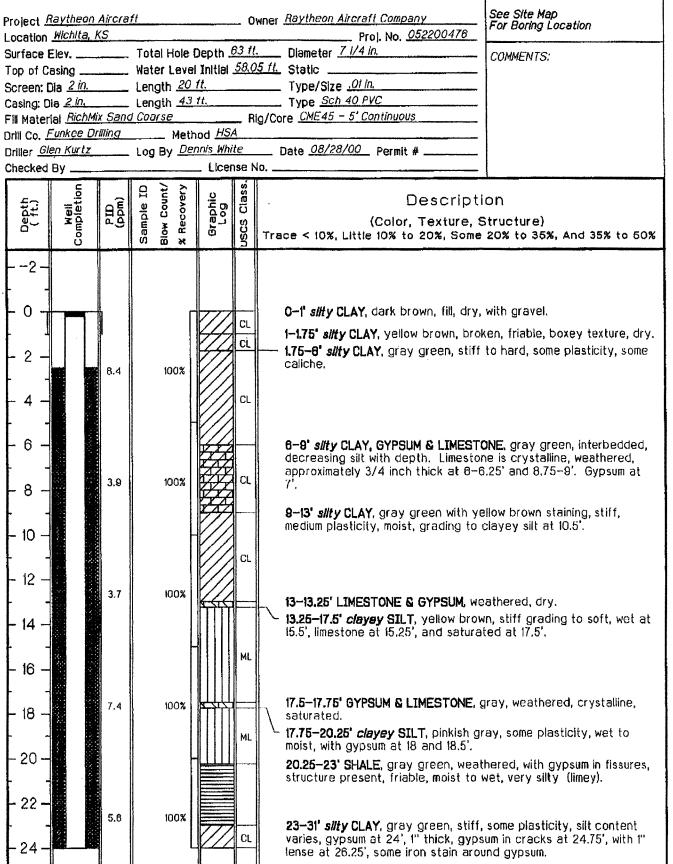


## Monitoring Well SAL-36I



## Drilling Log



Monitoring Well SAL-36I

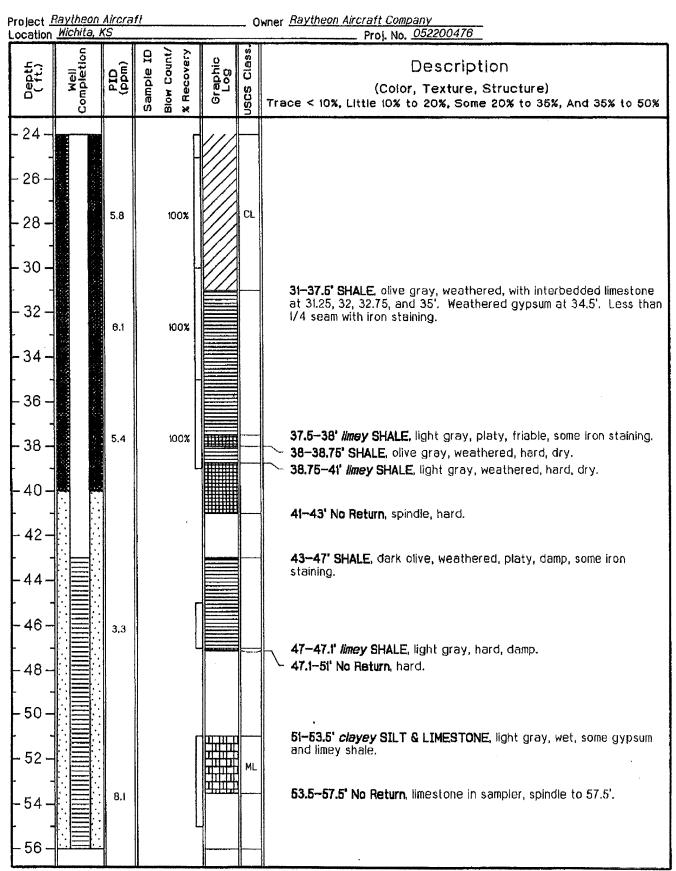

## **Drilling Log**



Monitoring Well SAL-36I

Project Raytheon Aircraft Owner Raytheon Aircraft Company Location Wichita, KS Proj. No. <u>052200476</u> Well Completion Class. Blow Count/ Recovery Graphic Log Description Depth (ft.) PID (mad) Sample SCS (Color, Texture, Structure) Trace < 10%, Little 10% to 20%, Some 20% to 35%, And 35% to 50% 56 **57.5-82.25' SHALE**, dark gray to dark gray green, platy, friable, wet at 58', saturated at 59.75'. - 58 -60 62 82.25-83' SHALE, light tan, dense, dry. 63' REFUSAL 64 66 68 -70 ·72· -74 - 76 -78 80 82 84 86 88

