


WATER WELL RECORD Form WWC-5

Original Record Correction Change in Well Use

Division of Water Resources App. No. Well ID

1 LOCATION OF WATER WELL: County: SEDGWICK Fraction NE 1/4 NE 1/4 SW 1/4 SE 1/4 Section Number 14 Township Number T 27 S Range Number R 2 E

2 WELL OWNER: Last Name: PISTOTNIK First: DEBBIE Business: Address: 14160 EAST PINNACLE DRIVE City: WICHITA State: KS ZIP: 67230 Street or Rural Address where well is located

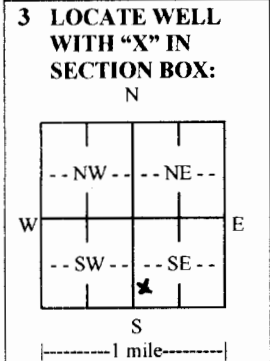

4 DEPTH OF COMPLETED WELL: 80 ft. Depth(s) Groundwater Encountered: 1) 47 ft. 2) ... ft. 3) ... ft., or 4) Dry Well WELL'S STATIC WATER LEVEL: 47 ft. below land surface...

5 Latitude: ... (decimal degrees) Longitude: ... (decimal degrees) Horizontal Datum: WGS 84 NAD 83 NAD 27 Source for Latitude/Longitude: GPS Land Survey Topographic Map Online Mapper

7 WELL WATER TO BE USED AS: 1. Domestic 2. Irrigation 3. Feedlot 4. Industrial 5. Public Water Supply 6. Dewatering 7. Aquifer Recharge 8. Monitoring 9. Environmental Remediation 10. Oil Field Water Supply 11. Test Hole 12. Geothermal 13. Other

Was a chemical/bacteriological sample submitted to KDHE? Yes No If yes, date sample was submitted: Water well disinfected? Yes No

8 TYPE OF CASING USED: Steel PVC Other CASING JOINTS: Glued Clamped Welded Threaded Casing diameter ... in. to ... ft. Diameter ... in. to ... ft. Casing height above land surface 13 in. Weight ... lbs./ft. Wall thickness or gauge No. SDG-26 TYPE OF SCREEN OR PERFORATION MATERIAL: Steel Stainless Steel Fiberglass PVC Other SCREEN OR PERFORATION OPENINGS ARE: Continuous Slot Mill Slot Gauze Wrapped Torch Cut Drilled Holes Other Louvered Shutter Key Punched Wire Wrapped Saw Cut None (Open Hole) SCREEN-PERFORATED INTERVALS: From 50 ft. to 80 ft. GRAVEL PACK INTERVALS: From 24 ft. to 80 ft.

9 GROUT MATERIAL: Neat cement Cement grout Bentonite Other Grout Intervals: From 3 ft. to 24 ft. Nearest source of possible contamination: Septic Tank Lateral Lines Pit Privy Livestock Pens Insecticide Storage Sewer Lines Cess Pool Sewage Lagoon Fuel Storage Abandoned Water Well Watertight Sewer Lines Seepage Pit Feedyard Fertilizer Storage Oil Well/Gas Well Other (Specify)

10 FROM TO LITHOLOGIC LOG FROM TO LITHO. LOG (cont.) or PLUGGING INTERVALS
Table with 6 columns and rows for TOP SOIL, CLAY, SHALE and Notes.

11 CONTRACTOR'S OR LANDOWNER'S CERTIFICATION: This water well was constructed, reconstructed, or plugged under my jurisdiction and was completed on (mo-day-year) 8/22/2017 and this record is true to the best of my knowledge and belief. Kansas Water Well Contractor's License No. 884 This Water Well Record was completed on (mo-day-year) 9/1/17 under the business name of WENINGER DRILLING, LLC Signature