

WATER WELL RECORD Form WWC-5


Division of Water Resources App. No.

Well ID

Original Record Correction Change in Well Use

1 LOCATION OF WATER WELL: County: SEDGWICK Fraction SW 1/4 NE 1/4 SE 1/4 NW 1/4 Section Number 26 Township Number T 27 S Range Number R 2 E W

2 WELL OWNER: Last Name: PRAIRIE CONSTRUCTION,LLC First: Street or Rural Address where well is located: 776 SOUTH GLENWOOD CT., WICHITA, KS, 67230

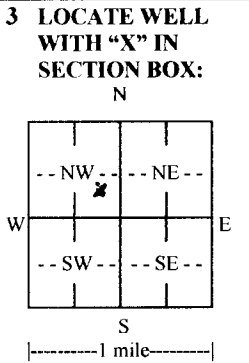

3 LOCATE WELL WITH "X" IN SECTION BOX: 4 DEPTH OF COMPLETED WELL: 80 ft. Depth(s) Groundwater Encountered: 1) 24 ft. 2) 3) or 4) Dry Well

5 Latitude: Longitude: Horizontal Datum: Source for Latitude/Longitude: 6 Elevation: 20 gpm Bore Hole Diameter: 10.5 in. to 80 ft. and

7 WELL WATER TO BE USED AS: 1. Domestic: 5. Public Water Supply: well ID 6. Dewatering: how many wells?

10. Oil Field Water Supply: lease 11. Test Hole: well ID 12. Geothermal: how many bores?

Was a chemical/bacteriological sample submitted to KDHE? Water well disinfected?

8 TYPE OF CASING USED: Steel PVC Other CASING JOINTS: Glued Clamped Welded Threaded Casing diameter 5 in. to 80 ft.

TYPE OF SCREEN OR PERFORATION MATERIAL: Steel Stainless Steel Fiberglass PVC Other (Specify)

SCREEN OR PERFORATION OPENINGS ARE: Continuous Slot Mill Slot Gauze Wrapped Torch Cut Drilled Holes Other (Specify)

SCREEN-PERFORATED INTERVALS: From 40 ft. to 80 ft. GRAVEL PACK INTERVALS: From 23 ft. to 80 ft.

9 GROUT MATERIAL: Neat cement Cement grout Bentonite Other Grout Intervals: From 3 ft. to 23 ft.

Nearest source of possible contamination: Septic Tank Lateral Lines Pit Privy Livestock Pens Insecticide Storage

Table with 6 columns: FROM, TO, LITHOLOGIC LOG, FROM, TO, LITHO. LOG (cont.) or PLUGGING INTERVALS. Rows include TOP SOIL, CLAY, LIMESTONE, SHALE, GYP.

11 CONTRACTOR'S OR LANDOWNER'S CERTIFICATION: This water well was constructed, reconstructed, or plugged under my jurisdiction and was completed on (mo-day-year) 8/14/2017

Mail 1 white copy along with a fee of \$5.00 for each constructed well to: Kansas Department of Health and Environment, Bureau of Water, GWTS Section, 1000 SW Jackson St., Suite 420, Topeka, Kansas 66612-1367.