

**WATER WELL PLUGGING RECORD Form WWC-5P**

KSA 82a-1212

ID NO.

MW 45-I


**1 LOCATION OF WATER WELL:** Fraction 1/4 SW 1/4 SW 1/4 NW 1/4 Section Number 10 Township Number T 27 S Range Number 2  E  W  
 County: Sedgwick

Street/Rural Address of Well Location; if unknown, distance & direction from nearest town or intersection: If at owner's address, check here  2000 N. 111th St East; Wichita, KS

**Global Positioning Systems (GPS) information:**  
 Latitude: 37.71724 (in decimal degrees)  
 Longitude: -97.20647 (in decimal degrees)  
 Elevation: \_\_\_\_\_  
 Horizontal Datum:  WGS84,  NAD83,  NAD27  
 Collection Method: \_\_\_\_\_

**2 WATER WELL OWNER:** Raytheon Aircraft Co.  
 RR#, St. Address, Box #: 9709 East Central  
 City, State ZIP Code: Wichita KS67202

GPS unit (Make/Model: Garmin etrek)  
 Digital Map/Photo,  Topographic Map,  Land Survey  
 Est. Accuracy:  < 3 m,  3-5 m,  5-15 m,  > 15 m

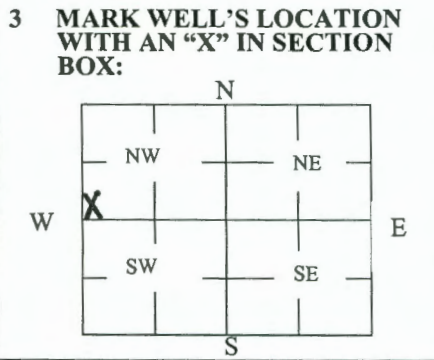

**4 DEPTH OF WELL** 55 ft.  
 WELL'S STATIC WATER LEVEL \_\_\_\_\_ ft  
 WELL WAS USED AS:  
 Domestic  Public Water Supply  Dewatering  
 Irrigation  Oil Field Water Supply  Monitoring  
 Feedlot  Domestic (Lawn & Garden)  Injection Well  
 Industrial  Air Conditioning  Other \_\_\_\_\_  
 Was a chemical/bacteriological sample submitted to Department? Yes  No

**5 TYPE OF BLANK CASING USED:**  
 Steel  RMP (SR)  Wrought  Fiberglass  Other (Specify below)  
 PVC  ABS  Asbestos-Cement  Concrete Tile  
 Blank casing diameter 2 in. Was casing pulled? Yes  No  If yes, how much 5  
 Casing height above or below land surface -6 in.

**6 GROUT PLUG MATERIAL:**  Neat cement  Cement grout  Bentonite  Other Top Soil  
 Grout Plug Intervals: From 0 ft. to 3 ft., From 3 ft. to 55 ft., From — ft. to — ft.  
 What is the nearest source of possible contamination:  
 Septic tank  Seepage pit  Fuel storage  Other (specify below)  
 Sewer lines  Pit privy  Fertilizer storage  
 Watertight sewer lines  Sewage lagoon  Insecticide storage  
 Lateral lines  Feedyard  Abandoned water well  Direction from well? southwest  
 Cess pool  Livestock pens  Oil well/Gas well  How many feet? 600

FROM	TO	PLUGGING MATERIALS	FROM	TO	PLUGGING MATERIALS
0	3	Top Soil			
3	55	Bentonite			

**7 CONTRACTOR'S OR LANDOWNER'S CERTIFICATION:** This water well was plugged under my jurisdiction and was completed on (mo/day/year) 01/30/2019 and this record is true to the best of my knowledge and belief. Kansas Water Well Contractor's License No. 710. This Water Well Record was completed on (mo/day/year) 01/31/2019 under the business name of Below Ground Surface, Inc. by (signature) Craig R. Hew

Send one white copy to Kansas Department of Health & Environment, Geology Section, 1000 SW Jackson Street, Ste. 420, Topeka, KS 66612-1367. Send one copy to WATER WELL OWNER and retain one for your records.  
 Visit us at <http://www.kdheks.gov/waterwell/index.html> Telephone 785-296-5524.

U:\Raytheon\_Storage\44811514\GIS\Documents\Project\_Maps\GIS\_148108\_038\_site\_map\_storage\_yard\_30\Well\_msd\_Analyt\_1.pxdm Line: 02/20/18 12:46:01 PM



**LEGEND**

- ◆ Shallow Monitor Well
- ◆ Intermediate Monitor Well
- ◆ Deep Monitor Well
- ◆ Well Plugged/Does Not Exist



2872 NORTH RIDGE ROAD, SUITE 102B  
WICHITA, KANSAS 67205  
(316) 220-8020

**SITE MAP  
STORAGE YARD AREA**

CLIENT:  
RAYTHEON COMPANY

LOCATION:  
STORAGE YARD  
WICHITA, KANSAS

FIGURE:  
1a