


WATER WELL RECORD Form WWC-5

Original Record Correction Change in Well Use

Division of Water Resources App. No. Well ID

1 LOCATION OF WATER WELL: County: Sedgwick Fraction NW 1/4 NE 1/4 Section Number 11 Township Number T 27 S Range Number R 2 E W

2 WELL OWNER: Last Name: First: Street or Rural Address where well is located: 2122 N Clear Creek St. Wichita KS 67228

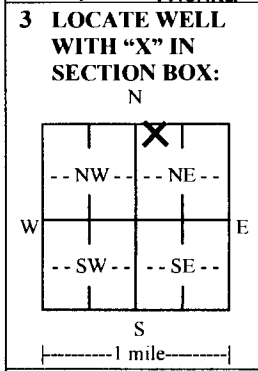

3 LOCATE WELL WITH 'X' IN SECTION BOX: 4 DEPTH OF COMPLETED WELL: 98' ft. WELL'S STATIC WATER LEVEL: 10' in. to 98' ft. and

5 Latitude: Longitude: Horizontal Datum: Source for Latitude/Longitude: GPS (unit make/model):

6 Elevation: Source: Land Survey GPS Topographic Map Other

7 WELL WATER TO BE USED AS: 1. Domestic: 2. Irrigation: 3. Feedlot: 4. Industrial: 5. Public Water Supply: well ID: 6. Dewatering: how many wells?: 7. Aquifer Recharge: well ID: 8. Monitoring: well ID: 9. Environmental Remediation: well ID: 10. Oil Field Water Supply: lease: 11. Test Hole: well ID: 12. Geothermal: how many bores?: 13. Other (specify):

Was a chemical/bacteriological sample submitted to KDHE? Water well disinfected?

8 TYPE OF CASING USED: Steel PVC Other CASING JOINTS: Glued Clamped Welded Threaded Casing diameter 5" in. to 98' ft. Diameter 12" in. Weight 160 lbs./ft. Wall thickness or gauge No. TYPE OF SCREEN OR PERFORATION MATERIAL: Steel Stainless Steel Fiberglass PVC Other (Specify) SCREEN OR PERFORATION OPENINGS ARE: Continuous Slot Mill Slot Gauze Wrapped Torch Cut Drilled Holes Other (Specify) SCREEN-PERFORATED INTERVALS: From 58' ft. to 98' ft. GRAVEL PACK INTERVALS: From 20' ft. to 98' ft.

9 GROUT MATERIAL: Neat cement Cement grout Bentonite Other Grout Intervals: From 3' ft. to 20' ft. Nearest source of possible contamination: Septic Tank Lateral Lines Pit Privy Livestock Pens Insecticide Storage Sewer Lines Cess Pool Sewage Lagoon Fuel Storage Abandoned Water Well Watertight Sewer Lines Seepage Pit Feedyard Fertilizer Storage Oil Well/Gas Well Other (Specify) Direction from well? South Distance from well? 75' + ft.

Table with 6 columns: FROM, TO, LITHOLOGIC LOG, FROM, TO, LITHO. LOG (cont.) or PLUGGING INTERVALS. Rows include Top Soil, Clay, Limestone, Gray Shale, Shaley Lime.

11 CONTRACTOR'S OR LANDOWNER'S CERTIFICATION: This water well was constructed, reconstructed, or plugged under my jurisdiction and was completed on (mo-day-year) 6/28/2018 and this record is true to the best of my knowledge and belief. Kansas Water Well Contractor's License No. 493 This Water Well Record was completed on (mo-day-year) 8/5/2019 under the business name of Reiserer Well Drilling Signature