
WATER WELL PLUGGING RECORD	Form WWC-5P	KSA 82a-1212	ID NO.	MW13
County: Sedgwick	Fraction SW 1/4 SE 1/4 SE 1/4 S	Section Number	Township Number T 27 S	Range Number 2 X E W
Street/Rural Address of Well Location; if unknown, distance & direction from nearest town or intersection: If at owner's address, check here		I ALL ALLA	Systems (GPS) inform	('
	Presto 90 E Central ta, KS 67206	GPS unit (Ma Digital Map/Ph		
A DEPTH OF WELL   11.90   ft.				
GROUT PLUG MATERIAL:    Neat cement				
7 CONTRACTOR'S OR LANDOWNER'S of completed on (mo/day/year) 4/3/2022 Contractor's License No. 757. This Water We business name of Larsen & Associates, Inc.  Send one white copy to Kansas Department 66612-1367. Sen	and this record is II Record was completed By (signatur	KDHE ID: Coas  This water well was strue to the best of mon (mo/day/year) c)  nt, Geology Section, 100  LL OWNER and retain	stal Mart #9166: U2-087 s plugged under my juris ry knowledge and belief. V3/2022 00 SW 4 kson Street, Ste. one for your records	diction and was Kansas Water under the
			Revised 1/20/2015	



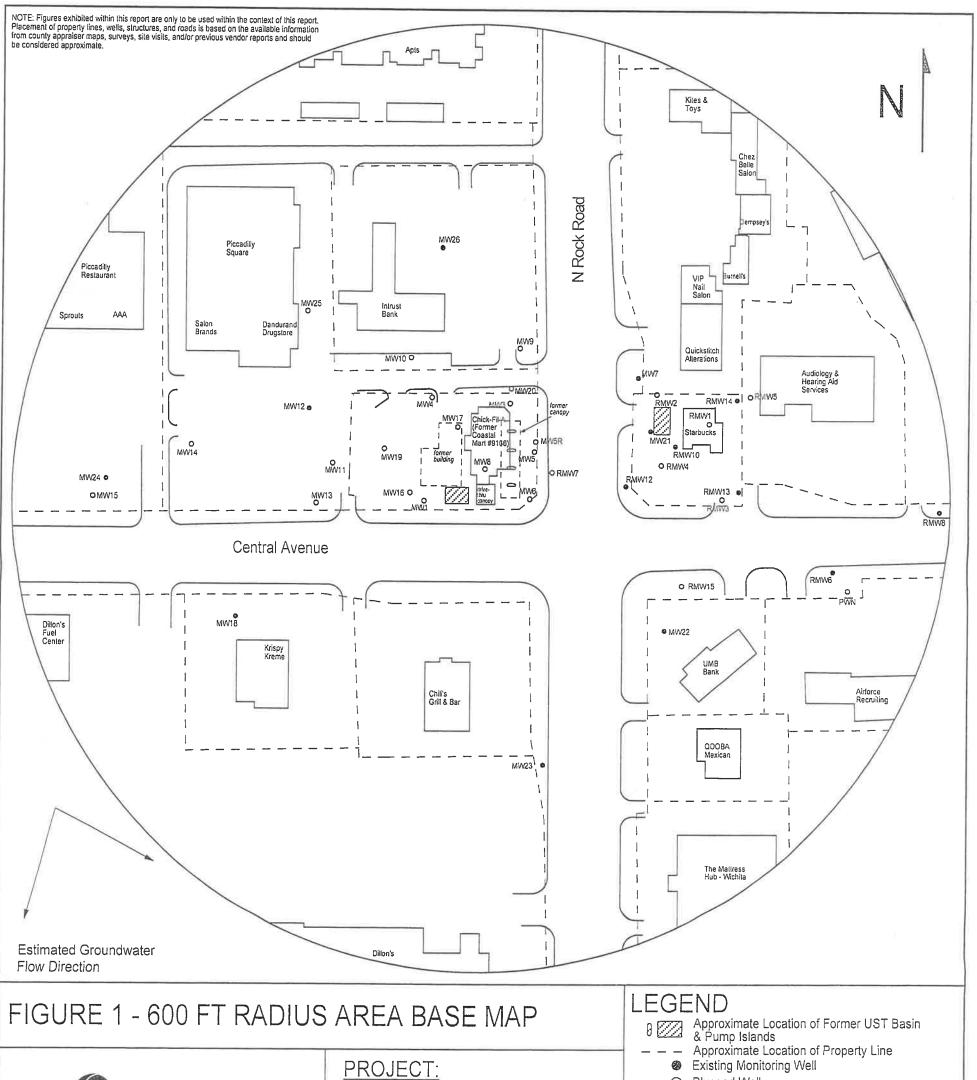

1311 E 25th St., Suite B Lawrence, KS 66046

785-841-8707 office 785-865-4282 fax Coastal Mart #9166 7990 E Central Wichita, KS KDHE ID: U2-087-13081 Date: 4/3/22

0 120 ft

O Plugged Well

NOTE: RMW wells are associated with Rock Road 66; U2-087-12613