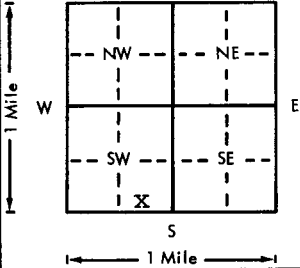


USE TYPEWRITER OR BALL
POINT PEN—PRESS FIRMLY,
PRINT CLEARLY.

WATER WELL RECORD
KSA 82a-1201-1215

Kansas Department of Health and
Environment—Division of Environment
(Water well Contractors)
Topeka, Kansas 66620

1. Location of well:		County Sedgwick	Fraction 1/4 S E 1/4 SW 1/4	Section number 13	Township number T 27 S	Range number R 2E E/W
2. Distance and direction from nearest town or city: 14800 East Central Street address of well location if in city: Wichita, Kansas			3. Owner of well: Solomon Inc. R.R. or street: 915 Douglas Bldg. City, state, zip code: Wichita, Kansas			
4. Locate with "X" in section below: 			Sketch map:			6. Bore hole dia. 11 in. Completion date 7-6-77 Well depth 80 ft.
5. Type and color of material			From	To	7. ☒ Cable tool ☒ Rotary ☐ Driven ☐ Dug ☐ Hollow rod ☐ Jetted ☐ Bored ☐ Reverse rotary	
			8. Use: ☐ Domestic ☐ Public supply ☐ Industry ☐ Irrigation ☐ Air conditioning ☐ Stock ☒ Lawn ☐ Oil field water ☐ Other			
			9. Casing: Material Styrene Height: Above or below Threaded ☐ Welded ☒ Surface 12 in. RMP ☒ PVC ☐ Weight ☐ lbs./ft. Dia. 5 in. to 80 ft. depth Wall Thickness: inches or Dia. ☐ in. to ☐ ft. depth gage No. 200			
			10. Screen: Manufacturer's name Sunflower Plastic Type Styrene Dia. 5" Slot/gauze .06 Length 40' Set between 40 ft. and 80 ft. ft. and ☐ ft. Gravel pack? yes Size range of material 1/4-1/8"			
			11. Static water level: ☐ mo./day/yr. 32 ft. below land surface Date 7-6-77			
(Use a second sheet if needed)			12. Pumping level below land surfaces: ☐ ft. after ☐ hrs. pumping ☐ g.p.m. ☐ ft. after ☐ hrs. pumping ☐ g.p.m. Estimated maximum yield ☐ g.p.m.		13. Water sample submitted: ☐ mo./day/yr. ☐ Yes ☐ No Date ☐	
			14. Well head completion: Capped ☐ Pitless adapter 12 inches above grade			
			15. Well grouted? yes 1 to 2 fine sand mix. With: ☐ Neat cement ☐ Bentonite ☒ Concrete Depth: From 40" ft. to 14 ft.			
			16. Nearest source of possible contamination: NONE ft. ☐ Direction ☐ Type ☐ Well disinfected upon completion? ☒ Yes ☐ No			
			17. Pump: ☒ Not installed Manufacturer's name ☐ Model number ☐ HP ☐ Volts ☐ Length of drop pipe ☐ ft. capacity ☐ g.p.m. Type: ☐ Submersible ☐ Turbine ☐ Jet ☐ Reciprocating ☐ Centrifugal ☐ Other			
18. Elevation: Topography: ☐ Hill ☒ Slope ☐ Upland ☐ Valley	19. Remarks: Septic system was not instilled when the well was drilled. No apparent source for contamination.					
			20. Water well contractor's certification: This well was drilled under my jurisdiction and this report is true to the best of my knowledge and belief. Harp Well & Pump 236 Business name License No. Address Wichita, Kansas Signed M. Arnold Date 8-31-77 Authorized representative			

Forward the white, blue and pink copies to the Department of Health and Environment

Form WWC-5