USE TYPEWRITER OR BALL POINT PEN-PRESS FIRMLY, PRINT CLEARLY.

WATER WELL RECORD
KSA 82a-1201-1215

Konsas Department of Health and Environment-Division of Environment
(Water well Contractors)
Topeka, Kansas 66620

| 1. Location of well: | County | Fraction | Section number | Township number | Range number |
|---|---|---|---|---|---|
| | Sedgwick | 1/4 SE 1/4 SE 1/4 | 13 | T 27 S | R 2E E/W |

2. Distance and direction from nearest town or city:
Street address of well locotion if in city: 536 Lancaster Wichita, Kansas

3. Owner of well: Challis Co.
R.R. or street: 15812 Stratford Roe
City, state, zip code: Wichita, Kansas

4. Locote with "X" in section below:

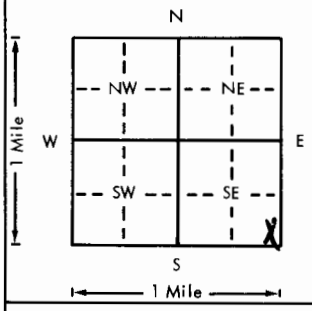


Sketch map:

6. Bore hole dia. 11 in. Completion date
Well depth 90 ft. 10-17-78

7. __ Cable tool X Rotary __ Driven __ Dug
__ Hollow rod __ Jetted __ Bored __ Reverse rotary

8. Use: X Domestic __ Public supply __ Industry
__ Irrigation __ Air conditioning __ Stock
__ Lawn __ Oil field water __ Other

9. Casing: Material Styrene Height: Above or below
Threaded ___ Welded gl Surface 12 in.
RMP X PVC ___ Weight ___ lbs./ft.
Dia. 5 in. to 90 ft. depth Wall Thickness: inches or
Dia. ___ in. to ___ ft. depth gage No. 200

| 5. Type and color of material | From | To |
|---|---|---|
| Topsoil | 0 | 3 |
| Clay | 3 | 8 |
| Grey shale | 8 | 90 |
| | | |
| | | |
| | | |
| | | |
| | | |
| | | |
| | | |
| | | |
| | | |
| | | |
| | | |
| (Use a second sheet if needed) | | |

10. Screen: Manufacturer's name Sunflower plastic
Type styrene Dia. 5"
Slot/gauze .06 Length 70'
Set between 20 ft. and 90 ft.
___ ft. and ___ ft.
Gravel pack? yes Size range of material 1/4-1/8"

11. Static water level: mo./day/yr.
15 ft. below land surface Date 10-17-78

12. Pumping level below land surfaces:
___ ft. after ___ hrs. pumping ___ g.p.m.
___ ft. after ___ hrs. pumping ___ g.p.m.
Estimated maximum yield ___ g.p.m.

13. Water sample submitted: mo./day/yr.
___ Yes ___ No Date

14. Well head completion: capped
___ Pitless adapter 12 Inches above grade

15. Well grouted? yes 1-2fine sand mix
With: ___ Neat cement ___ Bentonite X Concrete
Depth: From 40" ft. to 14 ft.

16. Nearest source af possible contamination:
ft. 95 Direction East Type Septic
Well disinfected upon completion? X Yes tank No

17. Pump: X Not installed
Manufacturer's name
Model number HP Volts
Length of drop pipe ft. capacity g.p.m.
Type:
___ Submersible ___ Turbine
___ Jet ___ Reciprocating
___ Centrifugal ___ Other

18. Elevation:

Topography:
___ Hill
___ Slope
___ Upland
___ Valley

19. Remarks:
Flat ground

20. Water well contractor's certification:
This well was drilled under my jurisdiction and this report is true to the best of my knowledge and belief.
Harp Well & Pump 236
Business name License No.
Address Wichita, Kansas 67209
Signed M. Arnold Date
Authorized representative 10-26-78

T 27 — R 2E W — Sec 13 — 1/4 1/4 1/4 SE SE

Forward the white, blue and pink copies to the Department of Health and Environment

Form WWC-5

MI-1023