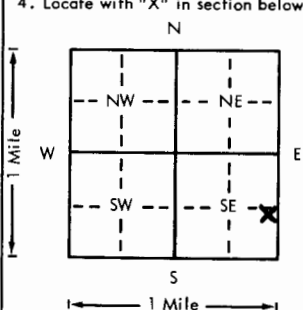


USE TYPEWRITER OR BALL
POINT PEN-PRESS FIRMLY,
PRINT CLEARLY.

WATER WELL RECORD
KSA 82a-1201-1215

Kansas Department of Health and
Environment-Division of Environment
(Water well Contractors)
Topeka, Kansas 66620

1. Location of well:		County SEDGWICK	Fraction 1/4 SE 1/4 SE 1/4	Section number 13	Township number T 27 S R 2E E/W
2. Distance and direction from nearest town or city: Street address of well location if in city:			3. Owner of well: R. D. Standrich, Inc. R.R. or street: P.O. Box 281 City, state, zip code: Derby, Kansas		
4. Locate with "X" in section below: 			Sketch map:		
5. Type and color of material			From	To	6. Bore hole dia. 11 in. Completing date 4-13-78 Well depth 96 ft.
Topsoil			0	2	7. ☒ Cable tool ☐ Rotary ☐ Driven ☐ Dug ☐ Hollow rod ☐ Jetted ☐ Bored ☐ Reverse rotary
Clay-Brown			2	14	8. Use: ☒ Domestic ☐ Public supply ☐ Industry ☐ Irrigation ☐ Air conditioning ☐ Stock ☐ Lawn ☐ Oil field water ☐ Other
Clay-Blue			14	28	9. Casing: Material styrene Height: Above or below Threaded ☐ Welded ☒ Surface 12 in. RMP ☒ PVC ☐ Weight ☐ lbs./ft. Dia. 5 in. to 96 ft. depth Wall Thickness: inches or Dia. ☐ in. to ☐ ft. depth gage No. .200
Blue Shale			28	96	10. Screen: Manufacturer's name Sunflower Plastic Type styrene Dia. 5" Slot/gauge 1/4" .06 Length 66' Set between 30 ft. and 96 ft. ☐ ft. and ☐ ft. Gravel pack? yes Size range of material 1/4-1/8"
					11. Static water level: 30 ft. below land surface Date 4-13-78 mo./day/yr.
					12. Pumping level below land surfaces: ☐ ft. after ☐ hrs. pumping ☐ g.p.m. ☐ ft. after ☐ hrs. pumping ☐ g.p.m. Estimated maximum yield ☐ g.p.m.
					13. Water sample submitted: ☐ Yes ☐ No Date ☐
					14. Well head completion: ☒ Pitless adapter 12 inches above grade
					15. Well grouted? yes 1-2 fine sand mix With: ☐ Neat cement ☒ Bentonite ☐ Concrete Depth: From 40 ft. to 14 ft.
					16. Nearest source of possible contamination: Septic Tank ft. 65 Direction West Type Tank Well disinfected upon completion? ☒ Yes ☐ No
					17. Pump: Manufacturer's name Pioneer Not installed Model number A18 HP 3/4 Volts 230 Length of drop pipe 50 ft. capacity 18 g.p.m. Type: ☒ Submersible ☐ Turbine ☐ Jet ☐ Reciprocating ☐ Centrifugal ☐ Other
18. Elevation:			19. Remarks: Flat Ground		
Topography: ☐ Hill ☐ Slope ☐ Upland ☐ Valley			20. Water well contractor's certification: This well was drilled under my jurisdiction and this report is true to the best of my knowledge and belief. Harp Well & Pump 236 Business name License No. Address Wichita, Kansas Signed M. Arnold Date 5-4-78 Authorized representative		

Forward the white, blue and pink copies to the Department of Health and Environment

Form WWC-5