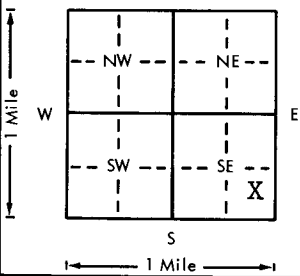


USE TYPEWRITER OR BALL
POINT PEN-PRESS FIRMLY,
PRINT CLEARLY.

WATER WELL RECORD
KSA 82a-1201-1215

Kansas Department of Health and
Environment-Division of Environment
(Water well Contractors)
Topeka, Kansas 66620

1. Location of well:		County SEDGWICK	Fraction 1/4 SE 1/4 SE 1/4	Section number 13	Township number T 27 S	Range number R 2E E/W																													
2. Distance and direction from nearest town or city: 15835 Sharon Lane Street address of well location if in city: Wichita, Kansas			3. Owner of well: Mike Stein R.R. or street: 6446 E. Bayley City, state, zip code: Wichita, Kansas																																
4. Locate with "X" in section below: 			Sketch map:			6. Bore hole dia. 11 in. Completion date _____ Well depth 90 ft. 5-25-78																													
<table border="1"><thead><tr><th>5. Type and color of material</th><th>From</th><th>To</th></tr></thead><tbody><tr><td>Topsoil</td><td>0</td><td>2</td></tr><tr><td>Brown Clay</td><td>2</td><td>6</td></tr><tr><td>Light Tan Clay</td><td>6</td><td>17</td></tr><tr><td>Light Tan Shale (Soft)</td><td>17</td><td>42</td></tr><tr><td>Blue Shale (Soft)</td><td>42</td><td>70</td></tr><tr><td>Blue Shale (Hard)</td><td>70</td><td>90</td></tr><tr><td></td><td></td><td></td></tr><tr><td></td><td></td><td></td></tr><tr><td></td><td></td><td></td></tr></tbody></table>			5. Type and color of material	From	To	Topsoil	0	2	Brown Clay	2	6	Light Tan Clay	6	17	Light Tan Shale (Soft)	17	42	Blue Shale (Soft)	42	70	Blue Shale (Hard)	70	90										7. ☒ Cable tool ☒ Rotary ☐ Driven ☐ Dug ☐ Hollow rod ☐ Jetted ☐ Bored ☐ Reverse rotary		
			5. Type and color of material	From	To																														
			Topsoil	0	2																														
			Brown Clay	2	6																														
			Light Tan Clay	6	17																														
			Light Tan Shale (Soft)	17	42																														
			Blue Shale (Soft)	42	70																														
			Blue Shale (Hard)	70	90																														
8. Use: ☒ Domestic ☐ Public supply ☐ Industry ☐ Irrigation ☐ Air conditioning ☐ Stock ☐ Lawn ☐ Oil field water ☐ Other																																			
9. Casing: Material Styrene Height: Above or below _____ Threaded _____ Welded gl Surface 12 in. RMP ☒ PVC _____ Weight _____ lbs./ft. Dia. 5 in. to 90 ft. depth Wall Thickness: inches or Dia. _____ in. to _____ ft. depth gage No. .200																																			
10. Screen: Manufacturer's name _____ Sunflower Plastic Type styrene Dia. 5" Slot 1/4" .06 Length 70' Set between 20 ft. and 90 ft. Gravel pack? yes Size range of material 1/4-1/8"																																			
11. Static water level: _____ mo./day/yr. 15 ft. below land surface Date 5-25-78																																			
12. Pumping level below land surfaces: _____ ft. after _____ hrs. pumping _____ g.p.m. _____ ft. after _____ hrs. pumping _____ g.p.m. Estimated maximum yield _____ g.p.m.																																			
13. Water sample submitted: _____ mo./day/yr. ☐ Yes ☐ No Date _____																																			
14. Well head completion: capped ☐ Pitless adapter 12 inches above grade																																			
15. Well grouted? yes 1-2 Fine Sand Mix With: ☐ Neat cement ☐ Bentonite ☒ Concrete Depth: From 40" ft. to 14 ft.																																			
16. Nearest source of possible contamination: ft. _____ Direction _____ Type NONE Well disinfected upon completion? ☒ Yes ☐ No																																			
17. Pump: ☒ Not installed Manufacturer's name _____ Model number _____ HP _____ Volts _____ Length of drop pipe _____ ft. capacity _____ g.p.m. Type: ☐ Submersible ☐ Turbine ☐ Jet ☐ Reciprocating ☐ Centrifugal ☐ Other																																			
(Use a second sheet if needed)																																			
18. Elevation: Topography: ☐ Hill ☐ Slope ☐ Upland ☐ Valley	19. Remarks: Flat Ground Septic system not installed at this time. No apparent source for contamination.		20. Water well contractor's certification: This well was drilled under my jurisdiction and this report is true to the best of my knowledge and belief. Harp Well & Pump 236 Business name License No. Address Wichita, Kansas 67209 Signed <i>[Signature]</i> Date 5-31-78 Authorized representative																																

Forward the white, blue and pink copies to the Department of Health and Environment

Form WWC-5