


1 LOCATION OF WATER WELL: Fraction NW 1/4 SW 1/4 NE 1/4 Section Number 14 Township Number T 27 S Range Number R 2 E
County: SEDGWICK

Distance and direction from nearest town or city street address of well if located within city?

3590 ft NORTH of SOUTHEAST CORNER AND 2298 WEST of SOUTHEAST CORNER

2 WATER WELL OWNER: CRESTVIEW COUNTRY CLUB ASSOCIATION, INC (OFFSET Well No. 4A)
RR#, St. Address, Box #: 1000 N. 12TH ST. EAST
City, State, ZIP Code: WICHITA, KANSAS 67206
Board of Agriculture, Division of Water Resources
Application Number:

3 LOCATE WELL'S LOCATION WITH AN "X" IN SECTION BOX:

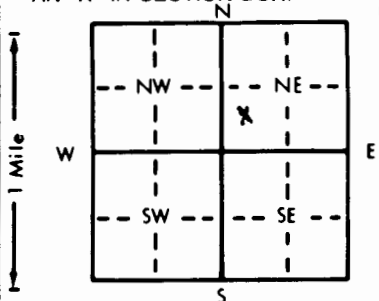

4 DEPTH OF COMPLETED WELL: 54 ft. ELEVATION:

Depth(s) Groundwater Encountered 1. ft. 2. ft. 3. ft.

WELL'S STATIC WATER LEVEL 15'-8" ft. below land surface measured on mo/day/yr

Pump test data: Well water was ft. after hours pumping gpm

Est. Yield 800 gpm: Well water was 21 ft. after 2 hours pumping 800 gpm

Bore Hole Diameter 18 in. to ft. and in. to ft.

WELL WATER TO BE USED AS: 5 Public water supply 8 Air conditioning 11 Injection well

1 Domestic 3 Feedlot 6 Oil field water supply 9 Dewatering 12 Other (Specify below)

2 Irrigation 4 Industrial 7 Lawn and garden only 10 Monitoring well

Was a chemical/bacteriological sample submitted to Department? Yes No X; If yes, mo/day/yr sample was submitted Water Well Disinfected? Yes X No

5 TYPE OF BLANK CASING USED:

- 1 Steel 3 RMP (SR)
2 PVC 4 ABS

- 5 Wrought iron 8 Concrete tile
6 Asbestos-Cement 9 Other (specify below)

- CASING JOINTS: Glued Clamped
Welded X
Threaded

Blank casing diameter 12 in. to ft. Dia 49.56 in. to ft. Dia

Casing height above land surface 30 in. weight lbs./ft. Wall thickness or gauge No. NA

TYPE OF SCREEN OR PERFORATION MATERIAL:

- 1 Steel 3 Stainless steel
2 Brass 4 Galvanized steel

- 5 Fiberglass 8 RMP (SR)
6 Concrete tile 9 ABS

10 Asbestos-cement

11 Other (specify)

12 None used (open hole)

SCREEN OR PERFORATION OPENINGS ARE:

- 1 Continuous slot 3 Mill slot
2 Louvered shutter 4 Key punched

- 5 Gauzed wrapped
6 Wire wrapped
7 Torch cut

- 8 Saw cut 11 None (open hole)
9 Drilled holes
10 Other (specify) OPEN HOLE

SCREEN-PERFORATED INTERVALS: From 44' ft. to 54' ft. From ft. to ft. From ft. to ft. From ft. to ft.

GRAVEL PACK INTERVALS: From NONE ft. to ft. From ft. to ft. From ft. to ft. From ft. to ft.

6 GROUT MATERIAL: 1 Neat cement 2 Cement grout 3 Bentonite 4 Other

Grout Intervals: From 0 ft. to 44 ft. From ft. to ft. From ft. to ft. From ft. to ft.

What is the nearest source of possible contamination:

- 1 Septic tank 4 Lateral lines 7 Pit privy
2 Sewer lines 5 Cess pool 8 Sewage lagoon
3 Watertight sewer lines 6 Seepage pit 9 Feedyard

- 10 Livestock pens 14 Abandoned water well
11 Fuel storage 15 Oil well/Gas well
12 Fertilizer storage 16 Other (specify below)
13 Insecticide storage

Direction from well? NORTH 20 FEET

How many feet? 30 FEET

FROM	TO	LITHOLOGIC LOG	FROM	TO	PLUGGING INTERVALS
0	2	TOP SOIL			
2	11	BROWN CLAY			
11	14	LIMESTONE WITH BROWN CLAY LAYERS			
14	15	GREEN SHALE WITH LIME LAYERS			
15	18	BLUE AND GRAY SHALE			
18	22	GRAY SHALE WITH LIME LAYERS			
22	26	GRAY SHALE			
26	34	BLACK AND GRAY SHALE			
34	36	BLACK SHALE			
36	37	GRAY SHALE			
37	44	GRAY SHALE AND LIMESTONE			
44	54	LOST CIRCULATION			

7 CONTRACTOR'S OR LANDOWNER'S CERTIFICATION: This water well was (1) constructed, (2) reconstructed, or (3) plugged under my jurisdiction and was completed on (mo/day/year) 5-13-93 and this record is true to the best of my knowledge and belief. Kansas Water Well Contractor's License No. 102 This Water Well Record was completed on (mo/day/yr) JUNE 10, 1993 under the business name of LAYNE, INC by (signature) James W. Daley