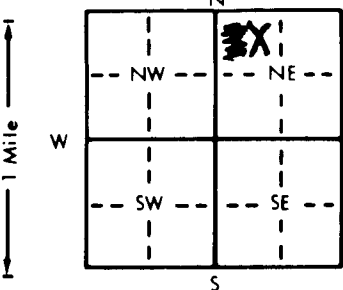


1 LOCATION OF WATER WELL: County: <u>Sedgwick</u>	Fraction <u>SW NW NE</u> <u>1/4 1/4 1/4</u>	Section Number <u>14</u>	Township Number <u>T 27 S</u>	Range Number <u>R 2 E</u>
--	--	--------------------------	-------------------------------	---------------------------

Distance and direction from nearest town or city street address of well if located within city?

2 1/2 Miles EAST of Wichita Ks.

2 WATER WELL OWNER: <u>LOUIS TAYLOR</u> RR#, St. Address, Box # : <u>1325 ST. Andrews drive</u> City, State, ZIP Code : <u>Wichita, Ks, 67230</u>	Board of Agriculture, Division of Water Resources Application Number:
---	--

3 LOCATE WELL'S LOCATION WITH AN "X" IN SECTION BOX: 	4 DEPTH OF COMPLETED WELL: <u>82</u> ft. ELEVATION: ft. Depth(s) Groundwater Encountered 1. <u>78</u> ft. 2. ft. 3. ft. WELL'S STATIC WATER LEVEL <u>22</u> ft. below land surface measured on mo/day/yr <u>6/6/92</u> Pump test data: Well water was ft. after hours pumping gpm Est. Yield <u>40</u> gpm: Well water was ft. after hours pumping gpm Bore Hole Diameter <u>10</u> in. to ft., and in. to ft. WELL WATER TO BE USED AS: 5 Public water supply 8 Air conditioning 11 Injection well 1 Domestic 3 Feedlot 6 Oil field water supply 9 Dewatering 12 Other (Specify below) 2 Irrigation 4 Industrial <u>Lawn and garden only</u> 10 Monitoring well Was a chemical/bacteriological sample submitted to Department? Yes.....No.....; If yes, mo/day/yr sample was submitted Water Well Disinfected? Yes ☒ No
--	--

5 TYPE OF BLANK CASING USED: 1 Steel <u>2 PVC</u> 3 RMP (SR) 4 ABS Blank casing diameter <u>5</u> in. to ft., Dia in. to ft., Dia in. to ft. Casing height above land surface <u>12</u> in., weight lbs./ft. Wall thickness or gauge No. TYPE OF SCREEN OR PERFORATION MATERIAL: 1 Steel 3 Stainless steel 5 Fiberglass 8 RMP (SR) 10 Asbestos-cement 2 Brass 4 Galvanized steel 6 Concrete tile 9 ABS 11 Other (specify) 12 None used (open hole) SCREEN OR PERFORATION OPENINGS ARE: 1 Continuous slot <u>3 Mill slot</u> 5 Gauzed wrapped 8 Saw cut 11 None (open hole) 2 Louvered shutter 4 Key punched 6 Wire wrapped 9 Drilled holes 7 Torch cut 10 Other (specify) SCREEN-PERFORATED INTERVALS: From <u>62</u> ft. to <u>82</u> ft., From ft. to ft. GRAVEL PACK INTERVALS: From <u>20</u> ft. to <u>82</u> ft., From ft. to ft.	CASING JOINTS: Glued Clamped Welded Threaded
--	--

6 GROUT MATERIAL: 1 Neat cement 2 Cement grout <u>3 Bentonite</u> 4 Other Grout Intervals: From <u>3</u> ft. to <u>20</u> ft., From ft. to ft., From ft. to ft. What is the nearest source of possible contamination: 1 Septic tank 4 Lateral lines 7 Pit privy 10 Livestock pens 14 Abandoned water well 2 Sewer lines 5 Cess pool 8 Sewage lagoon 11 Fuel storage 15 Oil well/Gas well <u>3 Watertight sewer lines</u> 6 Seepage pit 9 Feedyard 12 Fertilizer storage 16 Other (specify below) 13 Insecticide storage Direction from well? <u>down slope</u> How many feet?
--

FROM	TO	LITHOLOGIC LOG	FROM	TO	PLUGGING INTERVALS
0	2	earth			
2	16	brown clay			
16	72	yellow clay			
72	78	red clay			
78	82	shaley lime			

7 CONTRACTOR'S OR LANDOWNER'S CERTIFICATION: This water well was (1) constructed, (2) reconstructed, or (3) plugged under my jurisdiction and was completed on (mo/day/year) <u>6/6/92</u> and this record is true to the best of my knowledge and belief. Kansas Water Well Contractor's License No. <u>493</u> This Water Well Record was completed on (mo/day/yr) under the business name of <u>Reissner Well Drilling</u> by (signature) <u>Jenny Reissner</u>
--