


1 LOCATION OF WATER WELL:		Fraction	Section Number			Township Number			Range Number		
County: Sedgwick	NW	NE 1/4 NE 1/4 NE 1/4	14			T 27S S			R 2E E/W		

Distance and direction from nearest town or city street address of well if located within city?

14315 Northpoint Drive Wichita, Kansas 67230

2	WATER WELL OWNER: John Schultz	
	RR#, St. Address, Box # : 14315 Northpoint Drive	Board of Agriculture, Division of Water Resources
	City, State, ZIP Code : Wichita, Kansas 67230	Application Number:

3 LOCATE WELL'S LOCATION WITH AN "X" IN SECTION BOX:

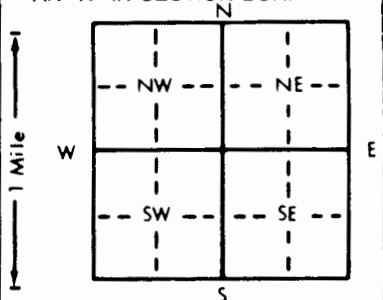

4 DEPTH OF COMPLETED WELL..... 75 ft. ELEVATION:

Depth(s) Groundwater Encountered 1. 45 ft. 2. ft. 3. ft.

WELL'S STATIC WATER LEVEL 25-30 ft. below land surface measured on mo/day/yr 6-22-94

Pump test data: Well water was ft. after hours pumping gpm

Est. Yield gpm: Well water was ft. after hours pumping gpm

Bore Hole Diameter . . . 9 . . . in. to . . . 75 . . . ft., and . . . in. to . . . ft.

WELL WATER TO BE USED AS: 5 Public water supply 8 Air conditioning 11 Injection well

1 Domestic	3 Feedlot	6 Oil field water supply	9 Dewatering	12 Other (Specify below)
------------	-----------	--------------------------	--------------	--------------------------

2 Irrigation 4 Industrial (7) Lawn and garden only 10 Monitoring well

Was a chemical/bacteriological sample submitted to Department? Yes.....No.....**x**.....; If yes, mo/day/yr sample was sub

mitted	Water Well Disinfected? Yes	☒	No
--------	-----------------------------	-------------------------------------	----

5	TYPE OF BLANK CASING USED:	5 Wrought iron	8 Concrete tile	CASING JOINTS: Glued . . X . . Clamped
---	----------------------------	----------------	-----------------	---

1 Steel	3 RMP (SR)	6 Asbestos-Cement	9 Other (specify below)	Welded
2 PVC	4 ABS	7 Fiberglass		Threaded

Blank casing diameter . . . 5 . . . in. to . . . 35 . . . ft., Dia . . . in. to . . . ft., Dia . . . in. to . . . ft.

Casing height above land surface. 24 in., weight lbs./ft. Wall thickness or gauge No. SDR26

TYPE OF SCREEN OR PERFORATION MATERIAL: 7) PVC 10. Asbestos-cement

1 Steel	3 Stainless steel	5 Fiberglass	8 RMP (SR)	11 Other (specify)		

2 Brass	4 Galvanized steel	6 Concrete tile	9 ABS	12 None used (open hole)
---------	--------------------	-----------------	-------	--------------------------

SCREEN OR PERFORATION OPENINGS ARE:

1 Continuous slot	2 Mill slot	5 Gauzed wrapped	8 Saw cut	11 None (open hole)
		6 Wire wrapped	9 Drilled holes	

1 Continuous slot	3 Mill slot	6 Wire wrapped	9 Drilled holes
2 Louvered shutter	4 Key punched	7 Torch cut	10 Other (specify)

SCREEN-PERFORATED INTERVALS: From . . . 35 . . . ft. to . . . 75 . . . ft., From . . . ft. to . . . ft.

GRAVEL BACK INTERVALS From ft. to ft., From ft. to ft.
From ~~5~~ 20 ft. to 75 ft. From ft. to ft.

GRAVEL PACK INTERVALS: From 28 20 ft. to 75 ft., From _____ ft. to _____ ft.
From _____ ft. to _____ ft. From _____ ft. to _____ ft.

6 GROUT MATERIAL: 1 Neat cement 2 Cement grout 3 Bentonite 4 Other

Grout Intervals: From 40 ft. to 20 ft., From _____ ft. to _____ ft., From _____ ft. to _____ ft.

What is the nearest source of possible contamination:


1 Septic tank	4 Lateral lines	7 Pit privy	11 Fuel storage	15 Oil well/gas well
2 Sewer lines	5 Cess pool	8 Sewage lagoon	12 Fertilizer storage	16 Other (specify below)

3 Watertight sewer lines	6 Seepage pit	9 Feedyard	13 Insecticide storage	
--------------------------	---------------	------------	------------------------	-------

Direction from well?			How many feet?		
FROM	TO	LITHOLOGIC LOG	FROM	TO	PLUGGING INTERVALS

[illegible]

7 CONTRACTOR'S OR LANDOWNER'S CERTIFICATION: This water well was (1) constructed, (2) reconstructed, or (3) plugged under my jurisdiction and was completed on (mo/day/year) 6-21-94 and this record is true to the best of my knowledge and belief. Kansas Water Well Contractor's License No. 171 This Water Well Record was completed on (mo/day/yr) 6-21-94 under the business name of G & S Drilling by (signature) *Edith Hanson*