


1 LOCATION OF WATER WELL: Fraction SE SW NW SW Section Number 271718 Township Number T 27 S Range Number R 2E E/W
 County: SEDGWICK

Distance and direction from nearest town or city street address of well if located within city?

800 Dublin, Wichita, Kansas

2 WATER WELL OWNER: Britt Brown
 RR#, St. Address, Box # : 800 Dublin
 City, State, ZIP Code : Wichita, Kansas
 Board of Agriculture, Division of Water Resources
 Application Number:

3 LOCATE WELL'S LOCATION WITH AN "X" IN SECTION BOX:

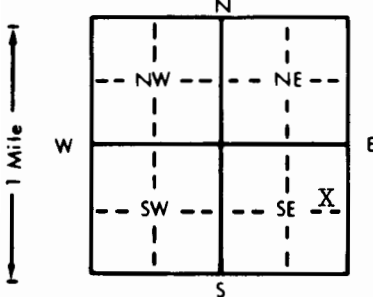

4 DEPTH OF COMPLETED WELL: 65 ft. ELEVATION: 12-15-82






WELL WATER TO BE USED AS: 5 Public water supply 8 Air conditioning 11 Injection well

1 Domestic 3 Feedlot 6 Oil field water supply 9 Dewatering 12 Other (Specify below)

2 Irrigation 4 Industrial 7 Lawn and garden only 10 Observation well

Was a chemical/bacteriological sample submitted to Department? Yes X No X; If yes, mo/day/yr sample was submitted

Water Well Disinfected? Yes X No X

5 TYPE OF BLANK CASING USED: 5 Wrought iron 8 Concrete tile CASING JOINTS: Glued X Clamped X

1 Steel 3 RMP (SR) 6 Asbestos-Cement 9 Other (specify below) Welded X

2 PVC 4 ABS 7 Fiberglass Threaded X


Casing height above land surface 12 in., weight 1.59 lbs./ft. Wall thickness or gauge No. 26

TYPE OF SCREEN OR PERFORATION MATERIAL: 7 PVC 10 Asbestos-cement

1 Steel 3 Stainless steel 5 Fiberglass 8 RMP (SR) 11 Other (specify)

2 Brass 4 Galvanized steel 6 Concrete tile 9 ABS 12 None used (open hole)

SCREEN OR PERFORATION OPENINGS ARE: 5 Gauzed wrapped 8 Saw cut 11 None (open hole)

1 Continuous slot 3 Mill slot 6 Wire wrapped 9 Drilled holes

2 Louvered shutter 4 Key punched 7 Torch cut 10 Other (specify)



6 GROUT MATERIAL: 1 Neat cement 2 Cement grout 3 Bentonite 4 Other


What is the nearest source of possible contamination: 10 Livestock pens 14 Abandoned water well

1 Septic tank 4 Lateral lines 7 Pit privy 11 Fuel storage 15 Oil well/Gas well

2 Sewer lines 5 Cess pool 8 Sewage lagoon 12 Fertilizer storage 16 Other (specify below)

3 Watertight sewer lines 6 Seepage pit 9 Feedyard 13 Insecticide storage None Apparnet

Direction from well? How many feet?

FROM TO LITHOLOGIC LOG FROM TO LITHOLOGIC LOG

0 3 Topsoil

3 14 Clay 01

14 65 Gray Shale and Limestone 21

7 CONTRACTOR'S OR LANDOWNER'S CERTIFICATION: This water well was (1) constructed, (2) reconstructed, or (3) plugged under my jurisdiction and was completed on (mo/day/year) 12-15-83 and this record is true to the best of my knowledge and belief. Kansas
 Water Well Contractor's License No. 236 This Water Well Record was completed on (mo/day/yr) 3-30-83
 under the business name of Harp Well & Pump Service, Inc. by (signature) M. Arnold
 INSTRUCTIONS: Use typewriter or ball point pen, PLEASE PRESS FIRMLY and PRINT clearly. Please fill in blanks, underline or circle the correct answers. Send top three copies to Kansas Department of Health and Environment, Division of Environment, Environmental Geology Section, Topeka, KS 66620. Send one to WATER WELL OWNER and retain one for your records.

OFFICE USE ONLY

T

27

R

2

EW

SEC.

18

SE

1/4

NE

1/4

SE

1/4

MJP