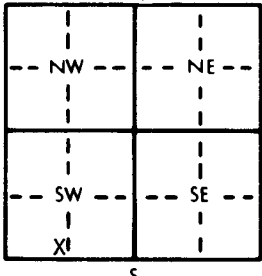
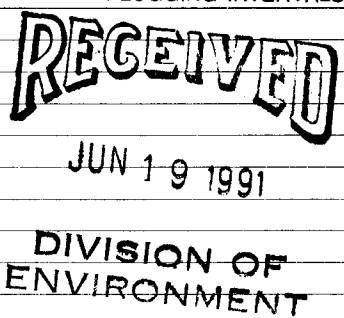


1 LOCATION OF WATER WELL: County: Sedgwick		Fraction SW 1/4 SW 1/4 SE 1/4	Section Number 19	Township Number T 27 S	Range Number R 2 E
Distance and direction from nearest town or city street address of well if located within city? 39 Ft. East and 52 Ft. South of NE Corner of Service Station, 7210 East Kellogg, Wichita, KS					
2 WATER WELL OWNER: Amoco Oil Company RR#, St. Address, Box #: 8700 Indian Creek Parkway, Building 3, Suite 180 City, State, ZIP Code: Overland Park, KS 66210					
Board of Agriculture, Division of Water Resources Application Number:					
3 LOCATE WELL'S LOCATION WITH AN "X" IN SECTION BOX: 		4 DEPTH OF COMPLETED WELL: 18.5 ft. ELEVATION: Approximate Surface Elevation 98.9 Depth(s) Groundwater Encountered 1. 13 ft. 2. ft. 3. ft. WELL'S STATIC WATER LEVEL 13 ft. below land surface measured on mo/day/yr 05/21/91 Pump test data: Well water was ft. after hours pumping gpm Est. Yield N/A gpm: Well water was ft. after hours pumping gpm Bore Hole Diameter 9 in. to 18.5 ft. and in. to ft. WELL WATER TO BE USED AS: 5 Public water supply 8 Air conditioning 11 Injection well 1 Domestic 3 Feedlot 6 Oil field water supply 9 Dewatering 12 Other (Specify below) 2 Irrigation 4 Industrial 7 Lawn and garden only 10 Monitoring well Was a chemical/bacteriological sample submitted to Department? Yes No X; If yes, mo/day/yr sample was submitted Water Well Disinfected? Yes No X			
5 TYPE OF BLANK CASING USED: 1 Steel 3 RMP (SR) 5 Wrought iron 8 Concrete tile CASING JOINTS: Glued Clamped 2 PVC 4 ABS 6 Asbestos-Cement 9 Other (specify below) Welded Blank casing diameter 2 in. to 8.5 ft. Dia in. to ft. Dia in. to ft. Casing height above land surface -2 in., weight lbs./ft. Wall thickness or gauge No. TYPE OF SCREEN OR PERFORATION MATERIAL: 1 Steel 3 Stainless steel 5 Fiberglass 8 RMP (SR) 10 Asbestos-cement 2 Brass 4 Galvanized steel 6 Concrete tile 9 ABS 11 Other (specify) SCREEN OR PERFORATION OPENINGS ARE: 1 Continuous slot 3 Mill slot 5 Gauzed wrapped 8 Saw cut 11 None (open hole) 2 Louvered shutter 4 Key punched 6 Wire wrapped 9 Drilled holes 7 Torch cut 10 Other (specify) SCREEN-PERFORATED INTERVALS: From 8.5 ft. to 18.5 ft. From ft. to ft. GRAVEL PACK INTERVALS: From 7.5 ft. to 18.5 ft. From ft. to ft. 6 GROUT MATERIAL: 1 Neat cement 2 Cement grout 3 Bentonite 4 Other Grout Intervals: From 0 ft. to 6.5 ft. From 6.5 ft. to 7.5 ft. From ft. to ft. What is the nearest source of possible contamination: 1 Septic tank 4 Lateral lines 7 Pit privy 10 Livestock pens 14 Abandoned water well 2 Sewer lines 5 Cess pool 8 Sewage lagoon 11 Fuel storage 15 Oil well/Gas well 3 Watertight sewer lines 6 Seepage pit 9 Feedyard 12 Fertilizer storage 16 Other (specify below) 13 Insecticide storage Direction from well? How many feet?					
FROM TO LITHOLOGIC LOG		FROM TO		PLUGGING INTERVALS	
0	.6	Asphalt			
.6	2.0	Dark Brown Lean Clay			
2.0	10.5	Gray Fat Clay			
10.5	18.5	Brown Lean Clay			
7 CONTRACTOR'S OR LANDOWNER'S CERTIFICATION: This water well was (1) constructed, (2) reconstructed, or (3) plugged under my jurisdiction and was completed on (mo/day/year) 05/21/91 and this record is true to the best of my knowledge and belief. Kansas Water Well Contractor's License No. 416 This Water Well Record was completed on (mo/day/yr) 6-1-91 under the business name of Terracon Consultants, Inc. by (signature) Steve Fischer					
INSTRUCTIONS: Use typewriter or ball point pen. PLEASE PRESS FIRMLY and PRINT clearly. Please fill in blanks, underline or circle the correct answers. Send top three copies to Kansas Department of Health and Environment, Bureau of Water, Topeka, Kansas 66620-7320. Telephone: 913-296-5545. Send one to WATER WELL OWNER and retain one for your records.					

OFFICE USE ONLY

T

R

EW

SEC.

1/4

1/4

1/4